


T. 1 N. & 1 S. R. 2 W. W. M.

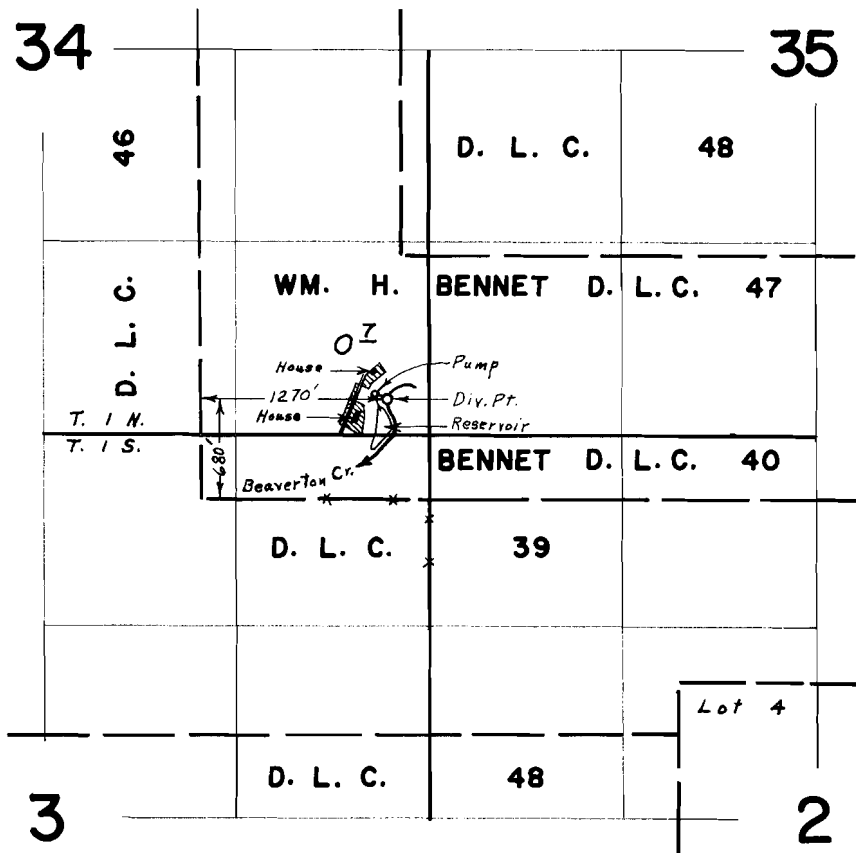

FINAL PROOF SURVEY UNDER

Application No. R-40798 40799 Permit No. R-4568 30398

IN NAME OF
GLADYS SMITH

Surveyed Sept. 15, 1967, by L. E. Gould