


Application No. R-40502
 Permit No. 40503.
 R-4582
 30447


h. a. mohr & ASSOCIATES
CIVIL ENGINEERS

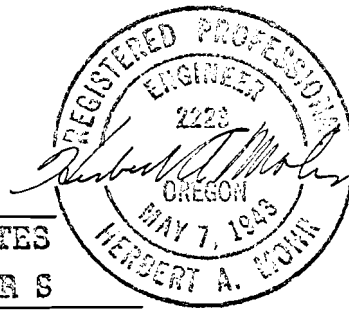

NOV 24 1964

227763

T.1 S.R.3 W.W.M.

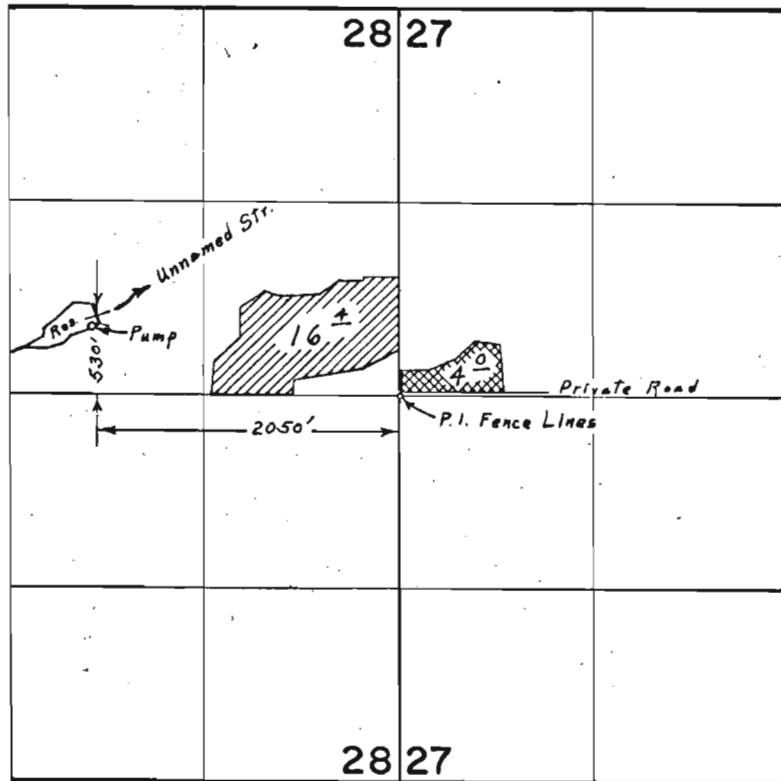

FINAL PROOF SURVEY UNDER

R-40502 R-4582
 40503 30447
 Application No. 42435 Permit No. 31750

IN NAME OF

CARL PIERSON

Surveyed Sept. 14, 1967, by L. E. Gould