


T. 1 S.R. 3 W.W.M.

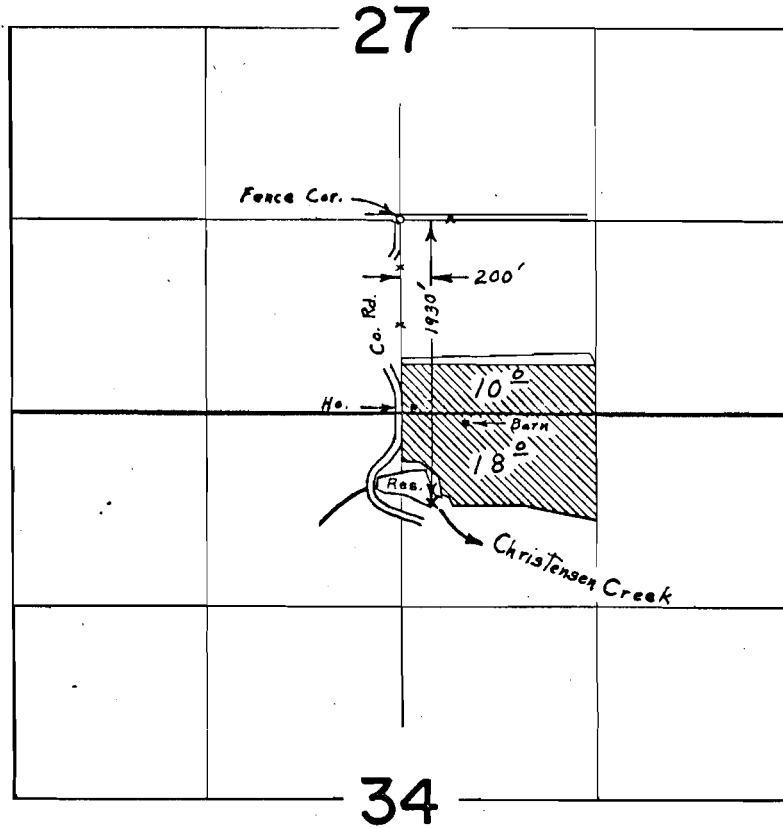

**FINAL PROOF SURVEY**  
UNDER

R-40935 R-4587  
Application No. 40933... Permit No. 30502.  
IN NAME OF

ARTHUR BEEVOR

.....  
Surveyed Sept. 13 1967, by L. E. Gould.