


T. 1 S.R. 3 W.W.M.

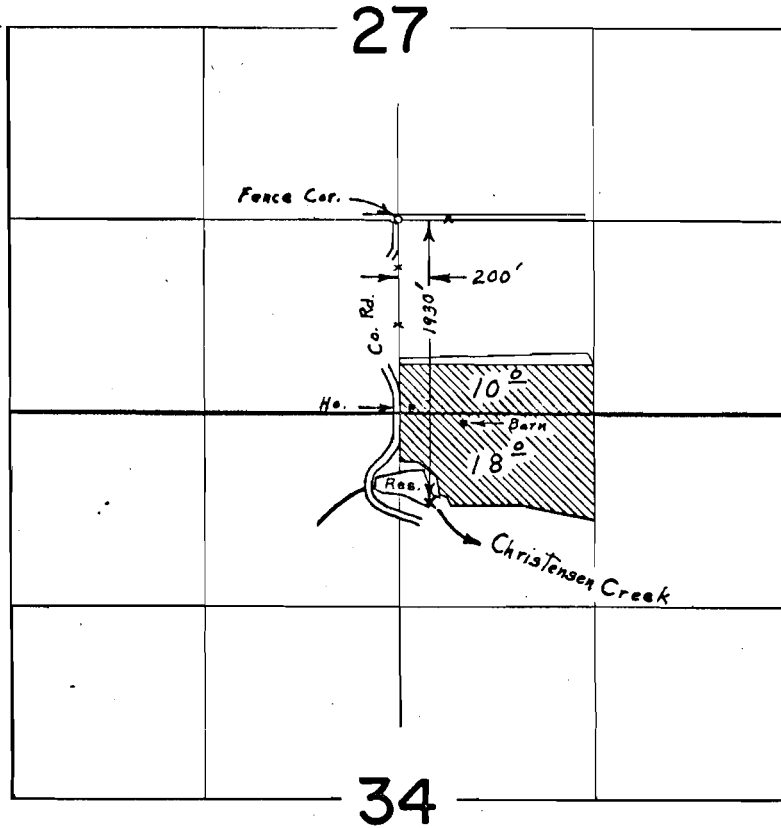

FINAL PROOF SURVEY
UNDER

R-40935 R-4587
Application No. 40933... Permit No. 30502.
IN NAME OF

ARTHUR BEEVOR

.....
Surveyed Sept. 13 1967, by L. E. Gould.