


T4S, R3W WM

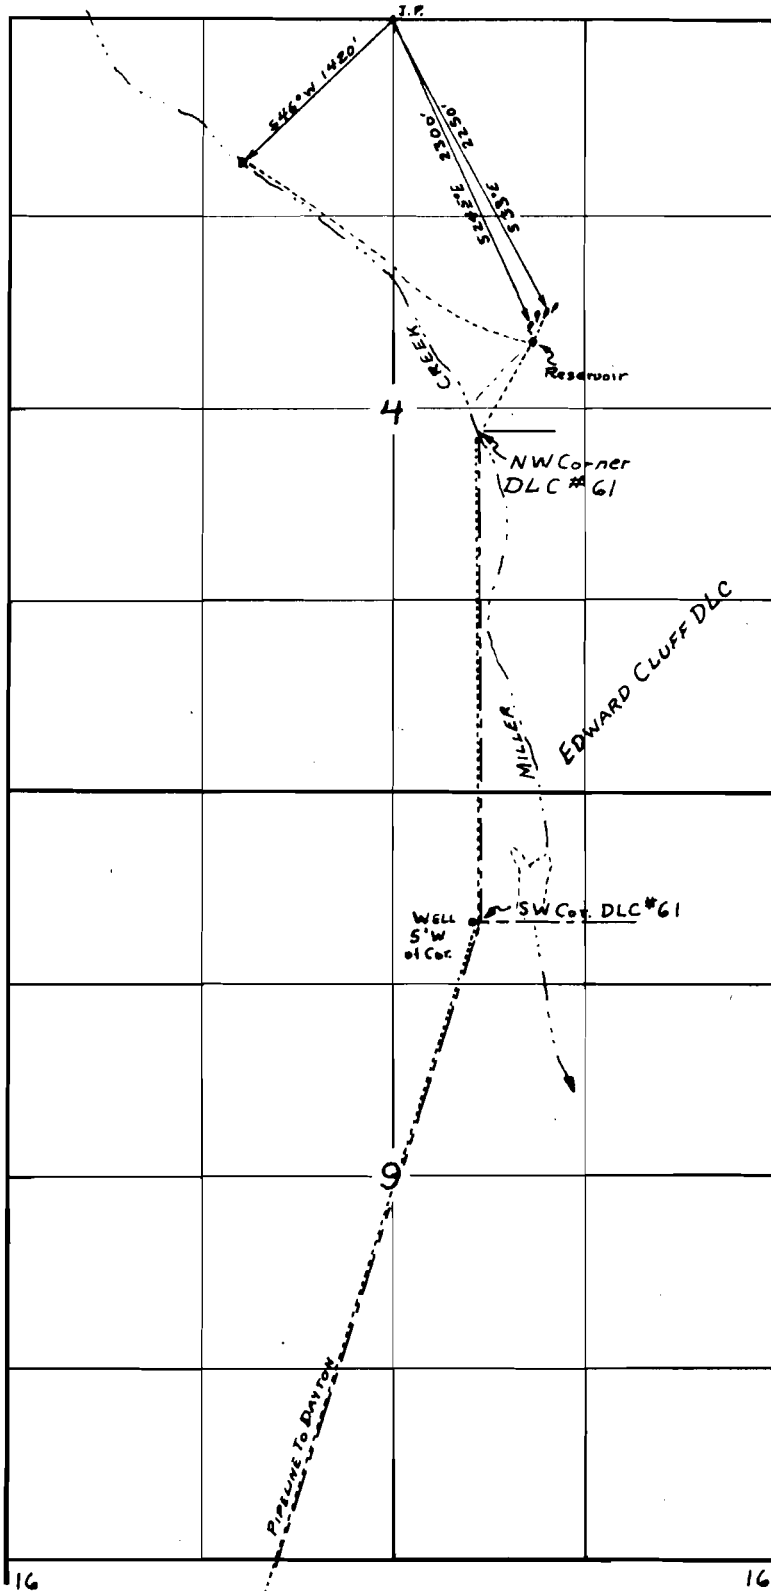

34218  
26950

CITY OF DAYTON MUNICIPAL WATER SUPPLY

6-1819 & 6-1820

6-1663 & 6-1664 DRG 1 OF 2