


T4S, R3W WM

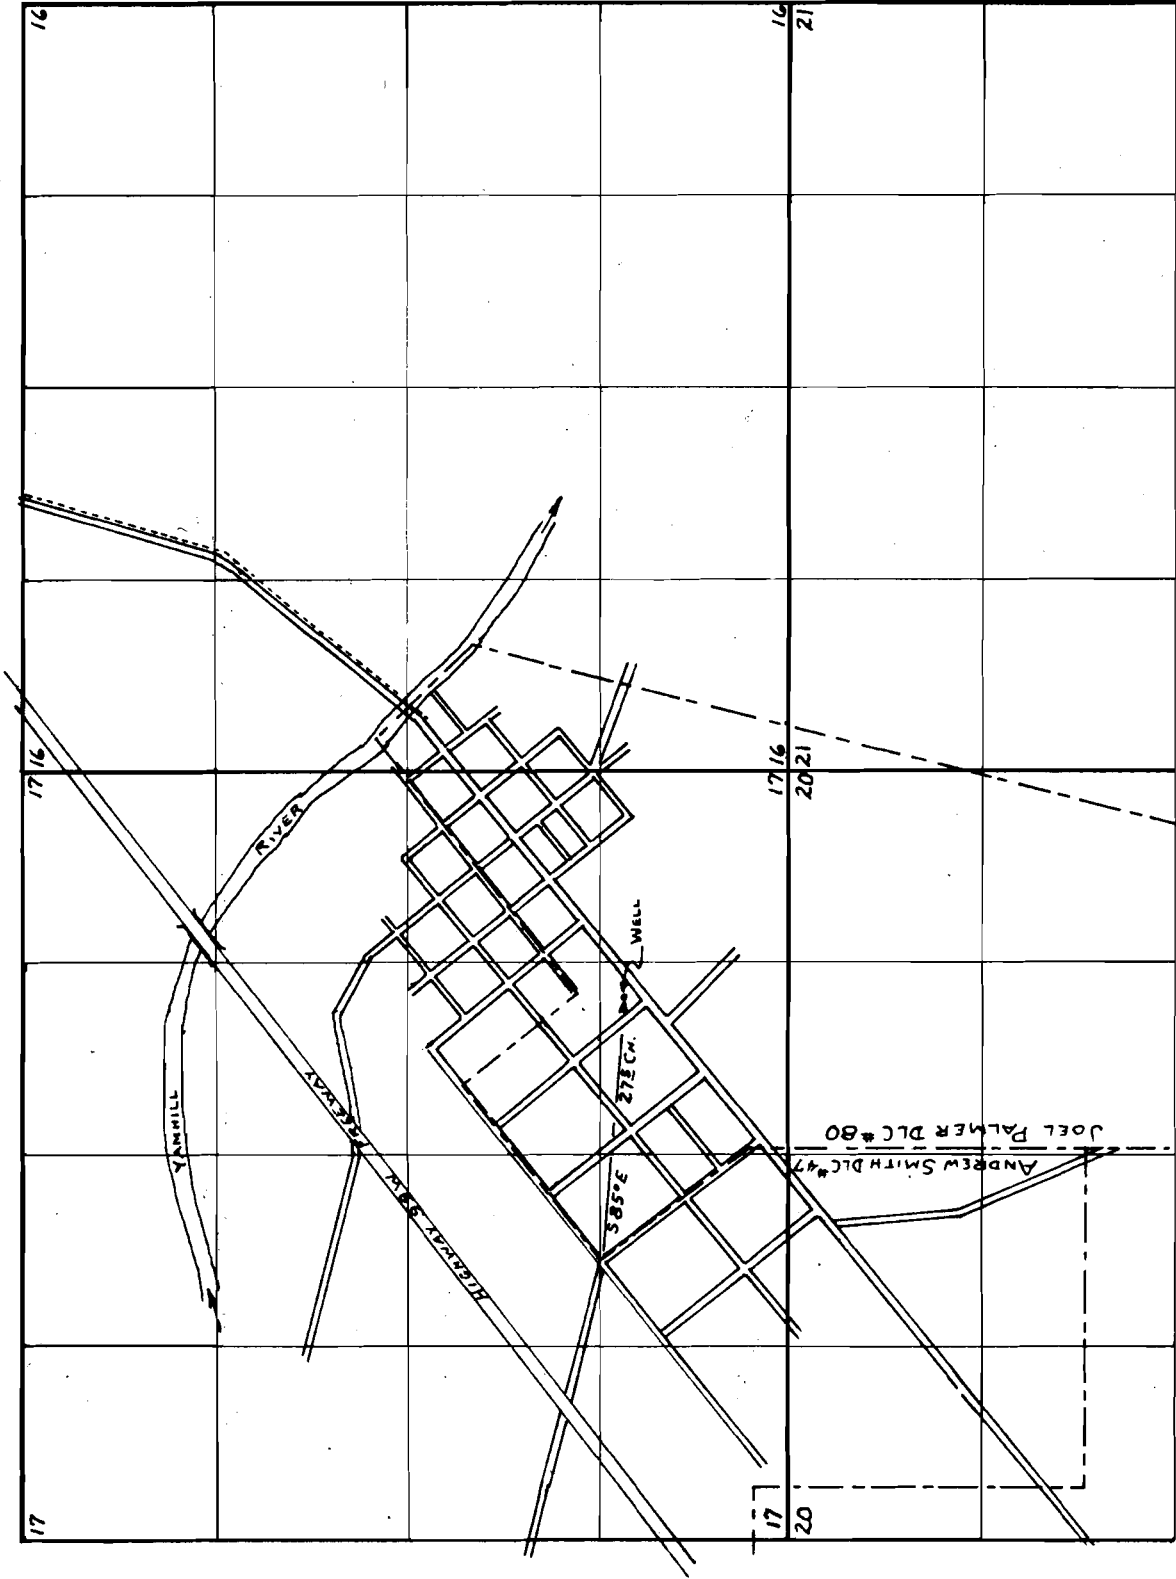

CITY OF DAYTON MUNICIPAL WATER SUPPLY

PROJECT NO. G-1819 & G-1820

DATE: 6-16-64

DRG 2 OF 2

34218
26950