


T. 4 S. R. 3 W. W.M.

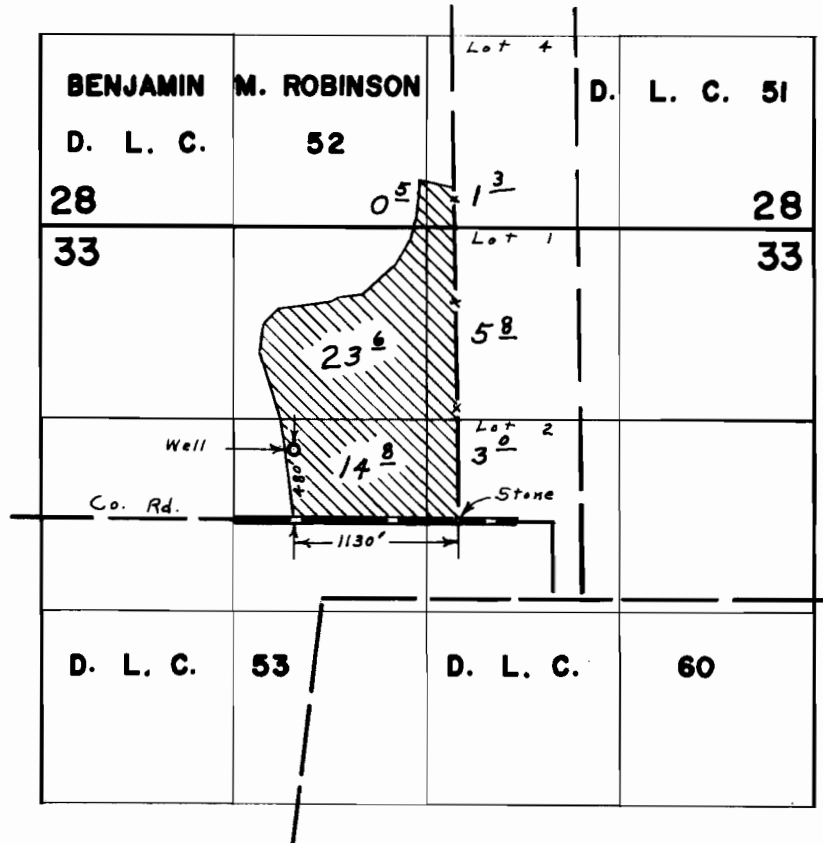

FINAL PROOF SURVEY UNDER

Application No. G-2184 Permit No. G-2013
 IN NAME OF
SAMUEL B. SWEENEY

Surveyed Sept. 8, 1967, by L. E. Gould