


T. 5 & 6 S. R. 4 W. W.M.

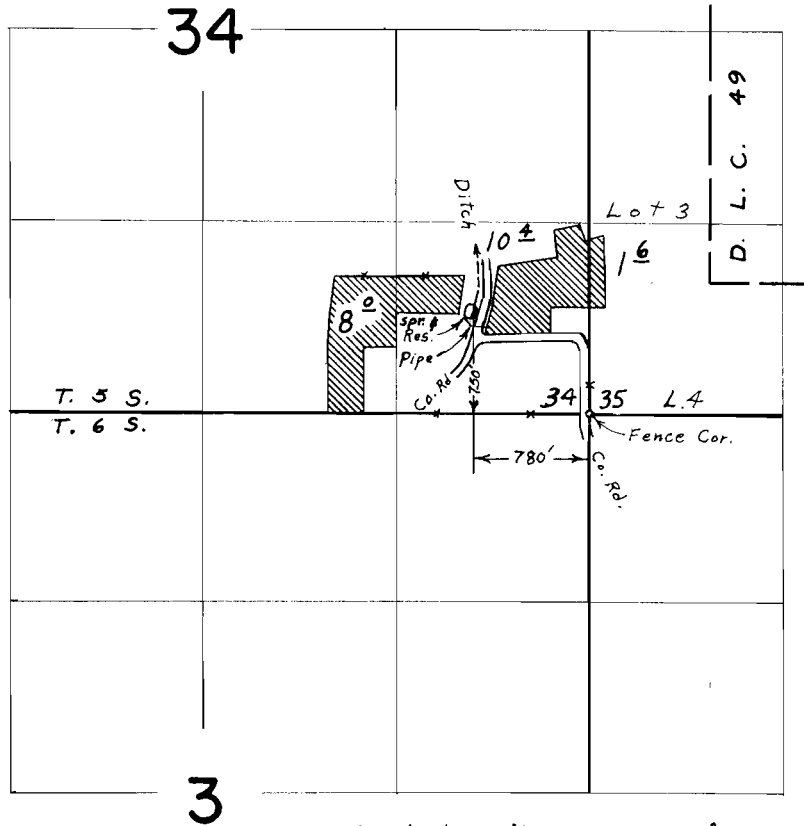

Spr. located 700 ft. N. & 830' W. from
S.E. Cor. Sec. 34

FINAL PROOF SURVEY UNDER

Application No. 34879 R-40242 40243 Permit No. 27584 R-4497 30008

IN NAME OF

HENRY GUSA

Surveyed *May 31, 1967*, by *L. E. Gould*