


T. 6 S. R. 8 W. W. M.

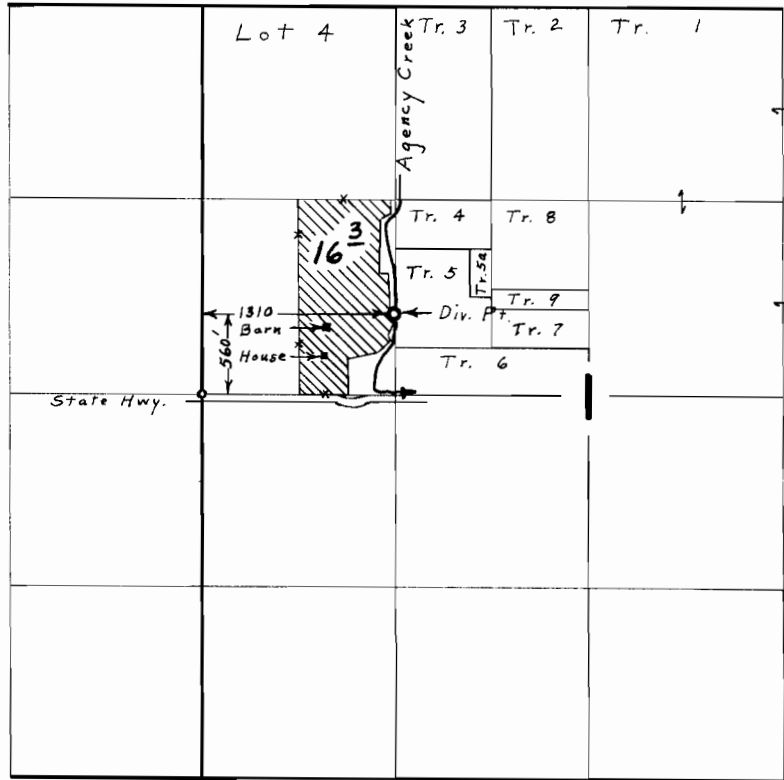

FINAL PROOF SURVEY UNDER

Application No. 37889 Permit No. 28235
IN NAME OF

OSCAR STROHMEYER

Surveyed Aug. 8, 1967, by L. E. Gould