




T.5 S.R.7 W.W.M.

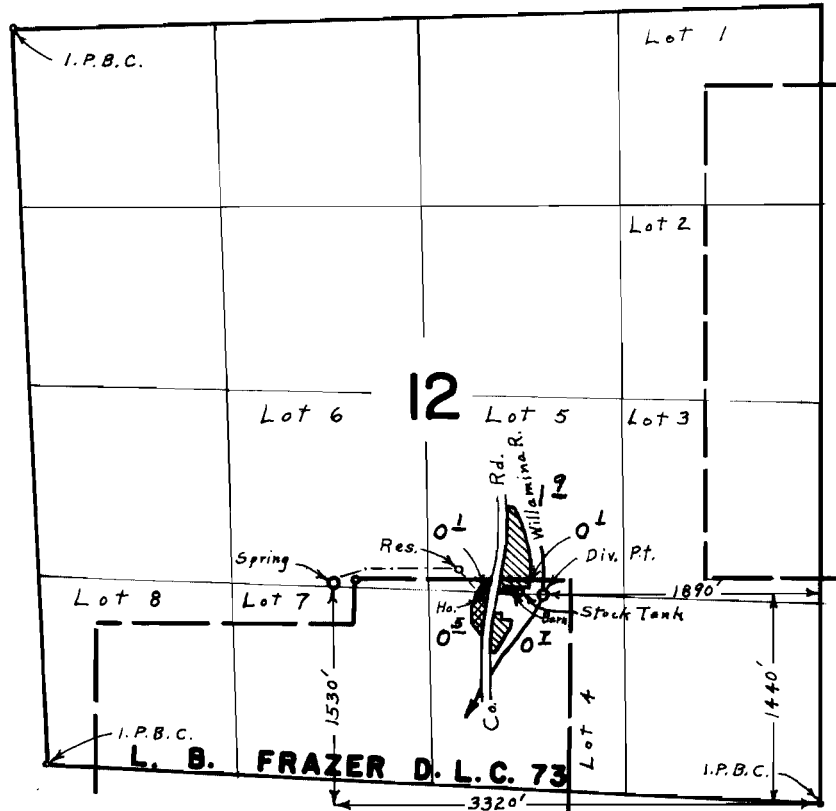

Land irrigated from spring 
Land irrigated from river 

FINAL PROOF SURVEY UNDER

Application No. 38/25 Permit No. 28413
IN NAME OF
ERNEST MENDENHALL

Surveyed June 1, 1967, by L. E. Gould