


T.5S.R.3W.W.M.

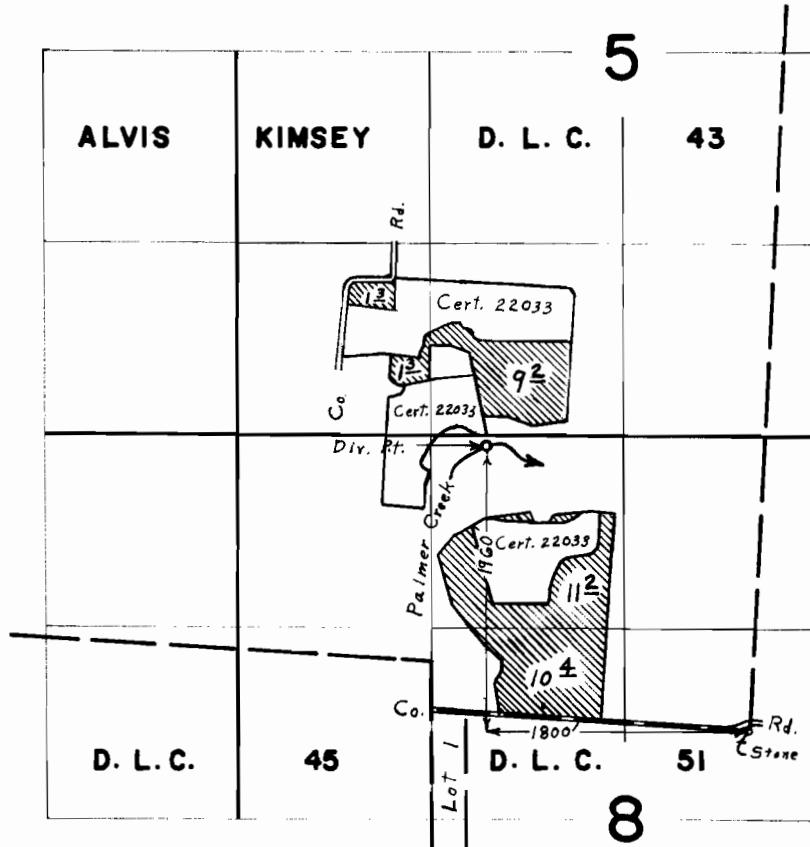

FINAL PROOF SURVEY UNDER

Application No. 38527 Permit No. 28671
IN NAME OF
FRANK ARMENTROUT

Surveyed April 18 1967, by L. E. Gould