


T.5 S.R.3 W.W.M.

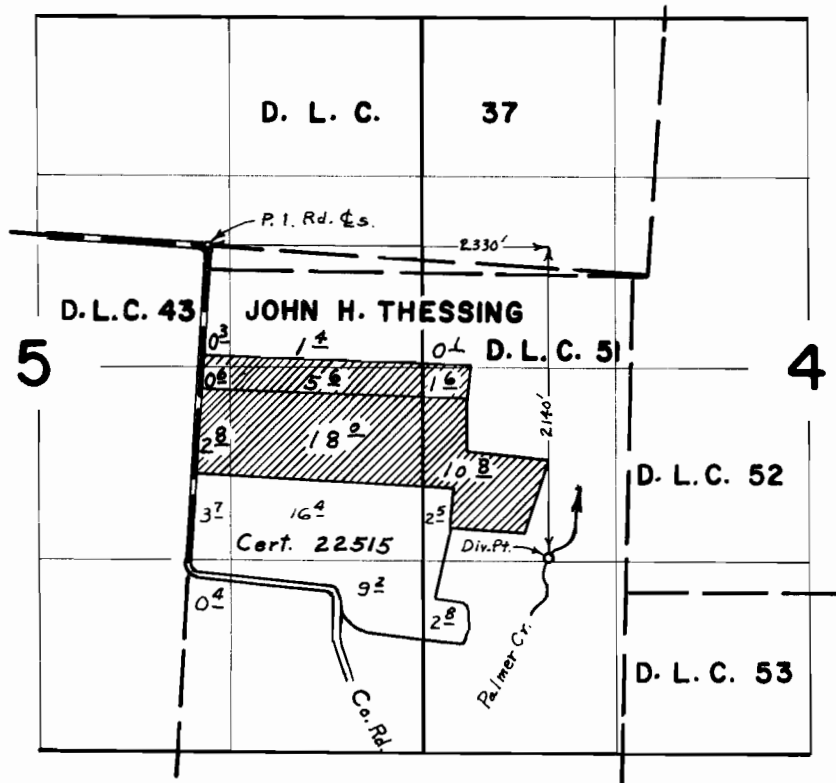

FINAL PROOF SURVEY UNDER

Application No. 38636 Permit No. 28759
IN NAME OF
PETER N. & ESSIE B. EDIGER

Surveyed April 19, 1967, by L. E. Gould