


T.5S. R.6W. W.M.

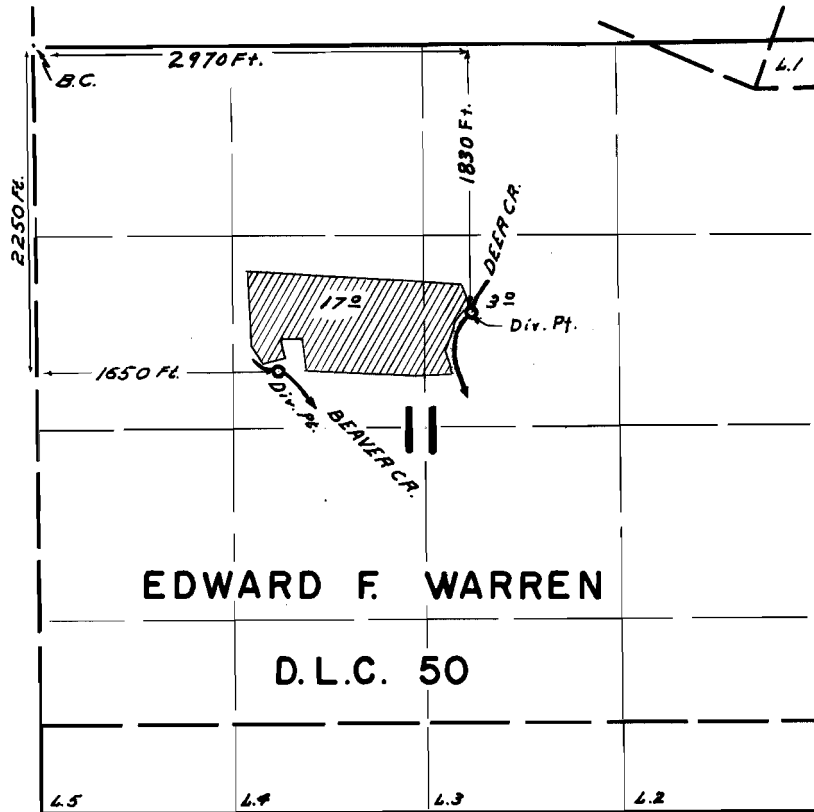

**FINAL PROOF SURVEY**  
UNDER

Application No. 40400. Permit No. 30125.  
IN NAME OF

**CLAUDE M. & VIOLA G. POMEROY**

Surveyed **NOV. 5 1965**, by **L. COLEBANK**  
**JULY 5 1967**, by **L. E. GOULD**