


T.5S.R.6W.W.M.

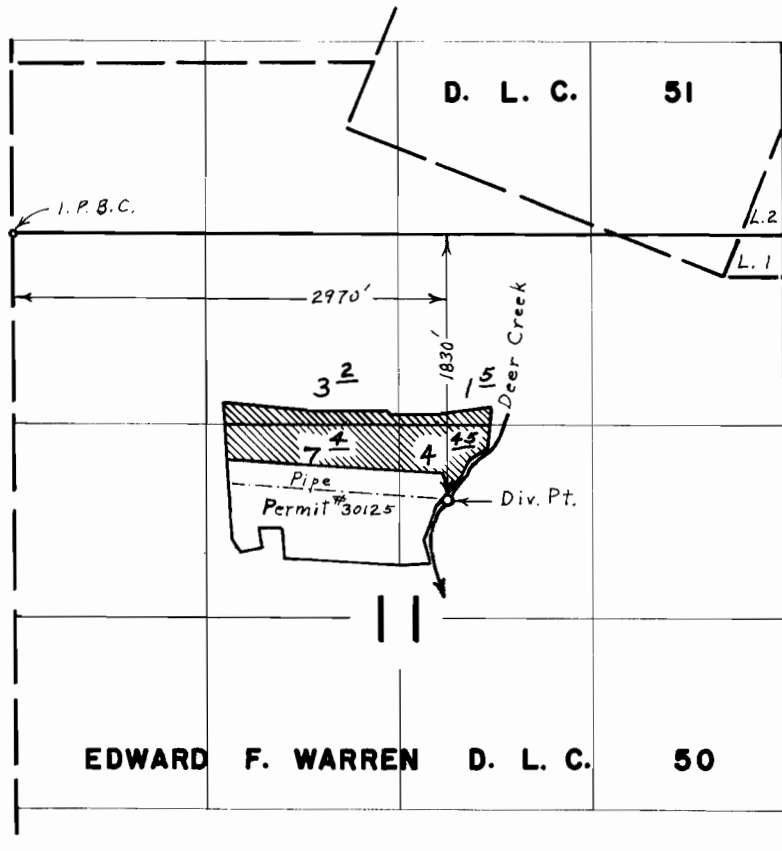

FINAL PROOF SURVEY UNDER

Application No. 42397 Permit No. 31666
IN NAME OF
CLAUDE M. AND VIOLA G. POMEROY

Surveyed July 5, 1967, by L. E. Gould