


# T. 6 S. R. 8 W. W. M.

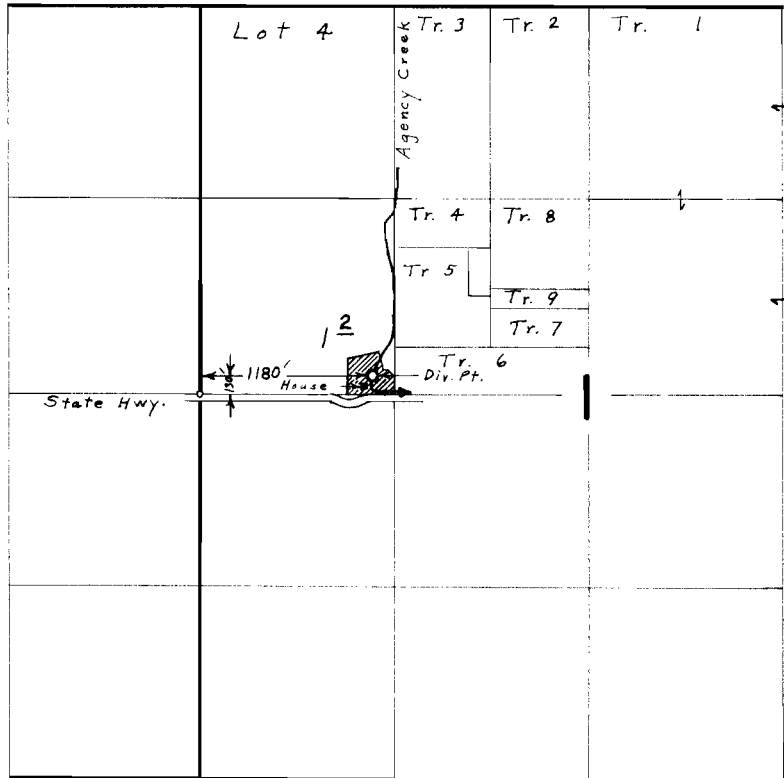

## FINAL PROOF SURVEY UNDER

Application No. 41090 Permit No. 30609  
IN NAME OF  
**ERWIN A. TIETJEN**

Surveyed Aug. 8, 1967, by L. E. Gould