


T.5 S.R.7 W.W.M.

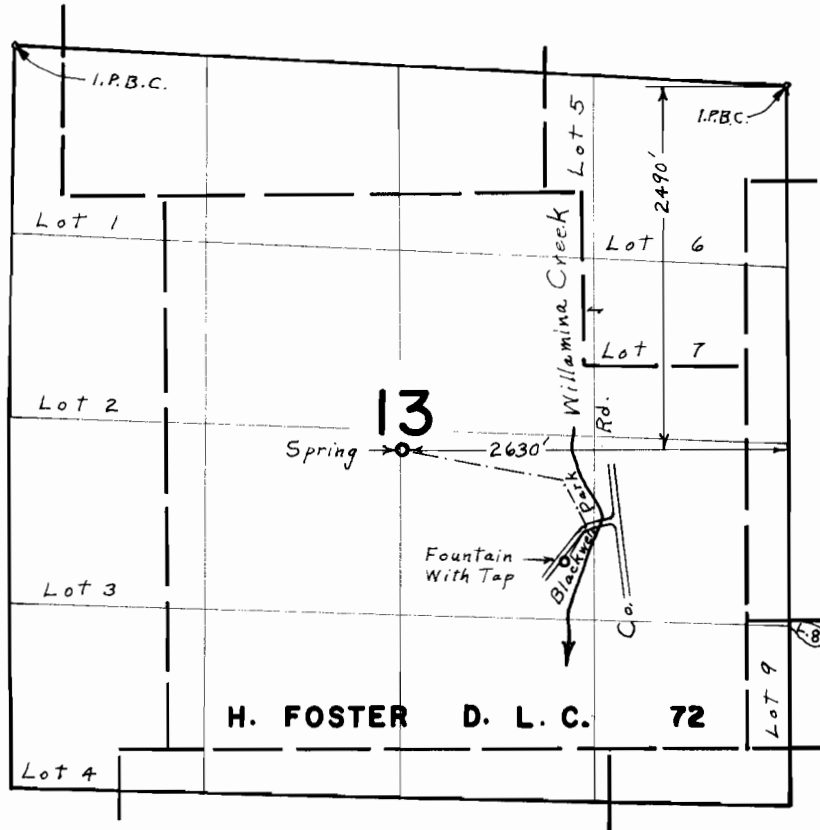

FINAL PROOF SURVEY UNDER

Application No. 41335 Permit No. 30864
IN NAME OF
YAMHILL COUNTY

Surveyed Aug 9 1967, by L. E. Gould