


T.5 S.R.6 W.W.M.

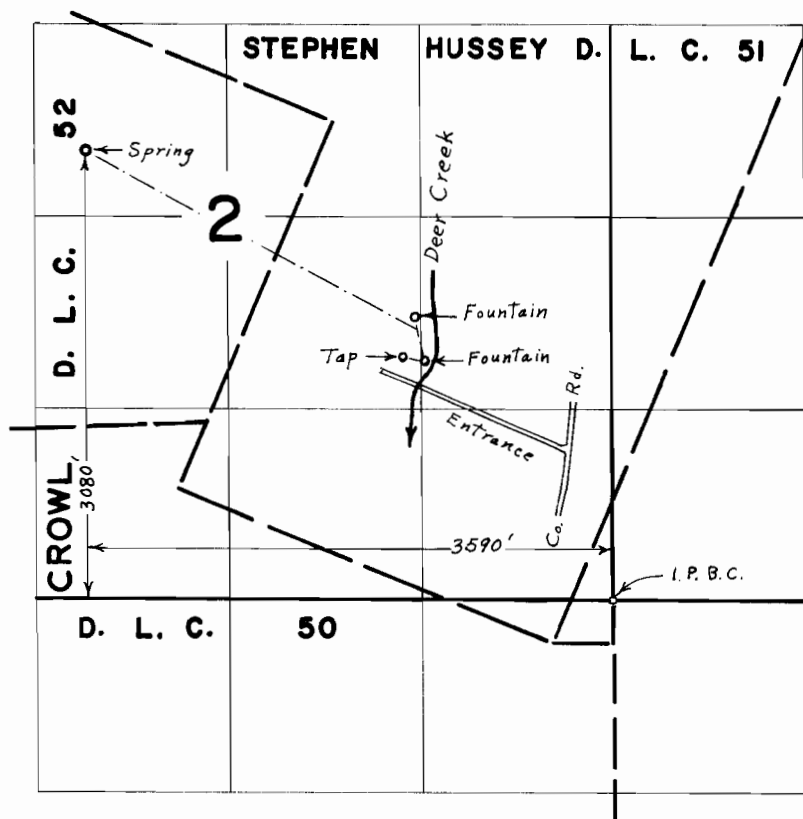

FINAL PROOF SURVEY UNDER

Application No. 41337 Permit No. 30866
IN NAME OF
YAMHILL COUNTY

Surveyed July 6, 1967, by L. E. Gauld