


T. 5 & 6 S. R. 7 W. W.M.

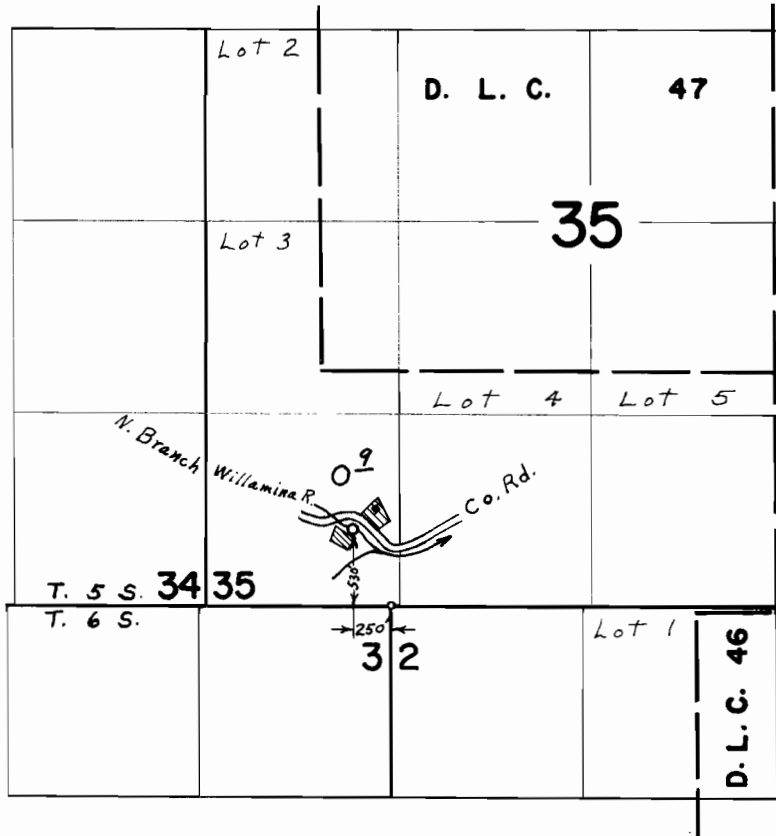

FINAL PROOF SURVEY UNDER

Application No. 41421 Permit No. 30939
IN NAME OF

WILLIAM EARL DICKEY

Surveyed June 2, 1967, by L. E. Gould