


T.5 S.R.8 W.W.M.

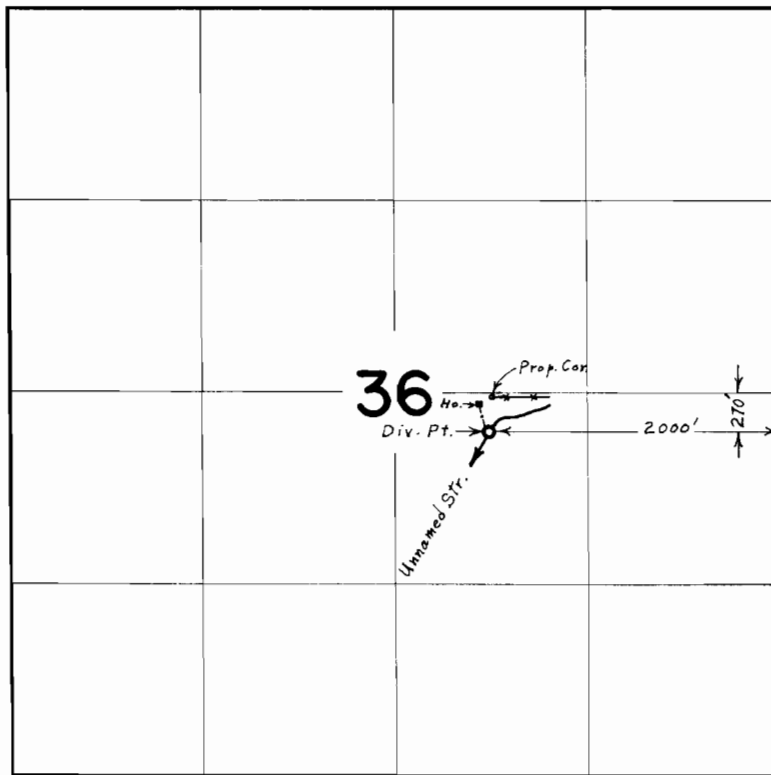

FINAL PROOF SURVEY
UNDER

Application No. 42426 Permit No. 31247
IN NAME OF

JASPER A. LILLARD

Surveyed Aug. 8, 1967, by L. E. Gould