


T.5 S.R.6 W.W.M.

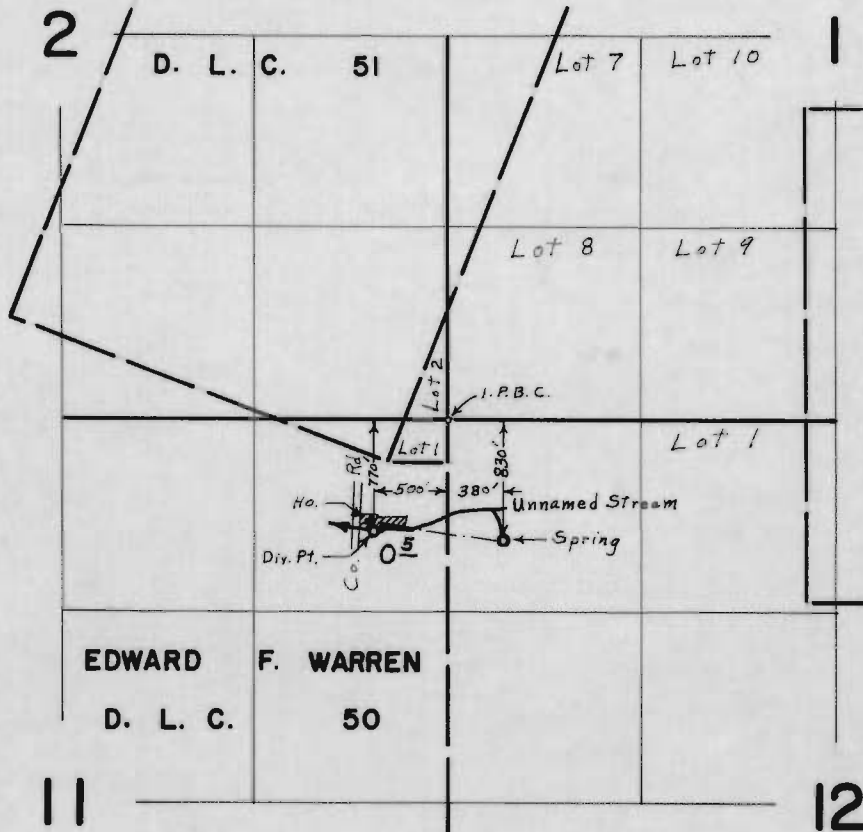

FINAL PROOF SURVEY UNDER

Application No. 42124 Permit No. 31507
 IN NAME OF
JOHN C. MCNEIL

Surveyed July 5, 1967, by L. E. Gould