


# T.13S.R.5W.W.M.

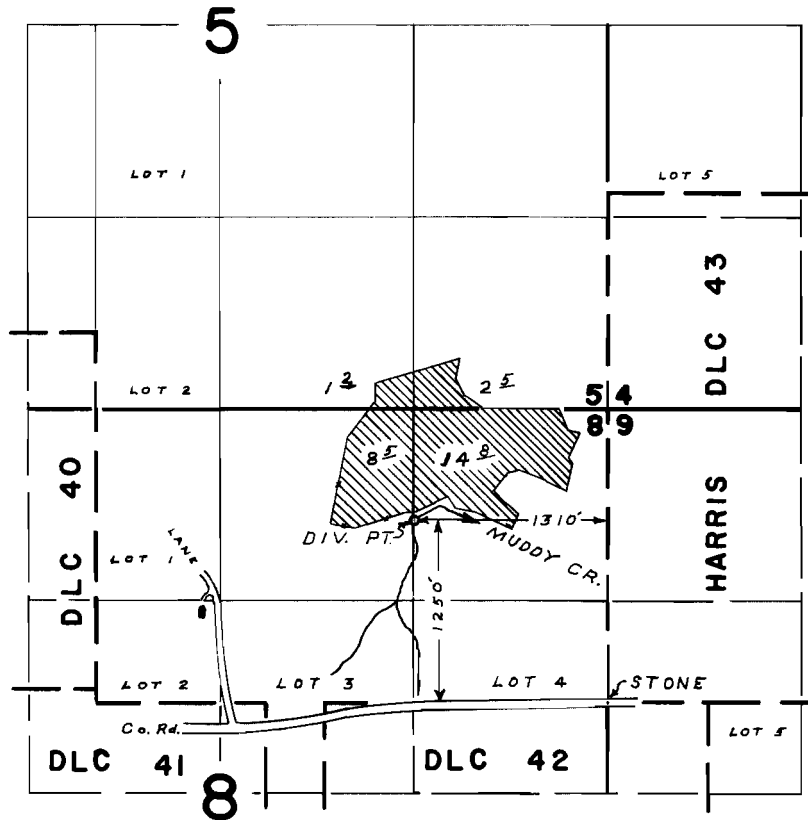

## FINAL PROOF SURVEY UNDER

Application No. **42927** Permit No. **32073**  
IN NAME OF

**VARDYN F & MARY J. BUCHANAN**

Surveyed **SEPT. 25 1968**, by **L. E. GOULD**