


T. 28 S. R. 14 W. W. M. .

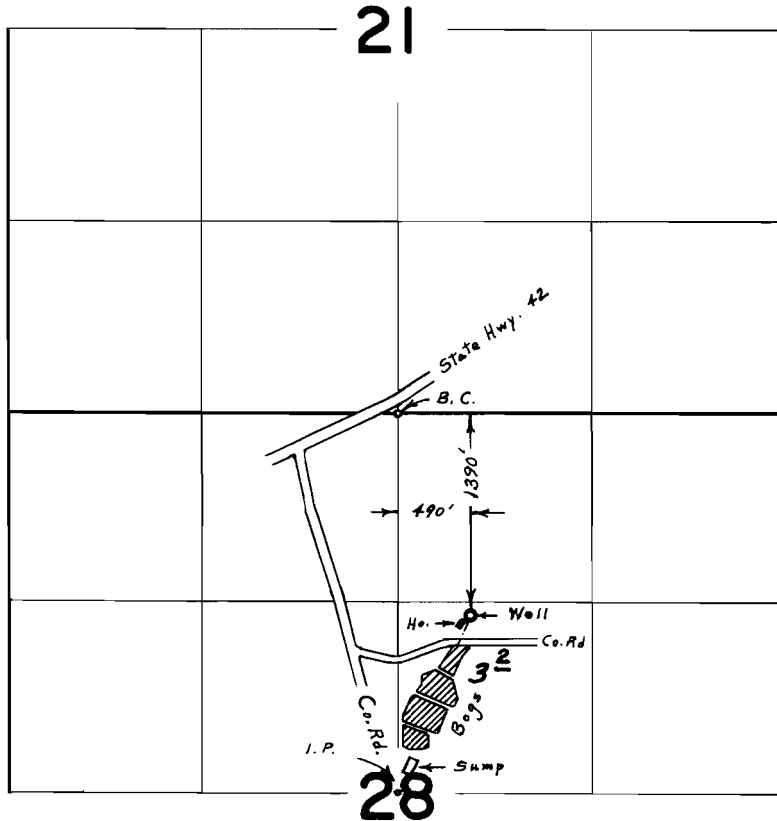

FINAL PROOF SURVEY
UNDER

Application No. G-3594 Permit No. G-3158
IN NAME OF

JOHN MILTON CONRAD

Surveyed July 16, 1968, by L. E. Gould