


T.29 S.R.14 W.W.M.

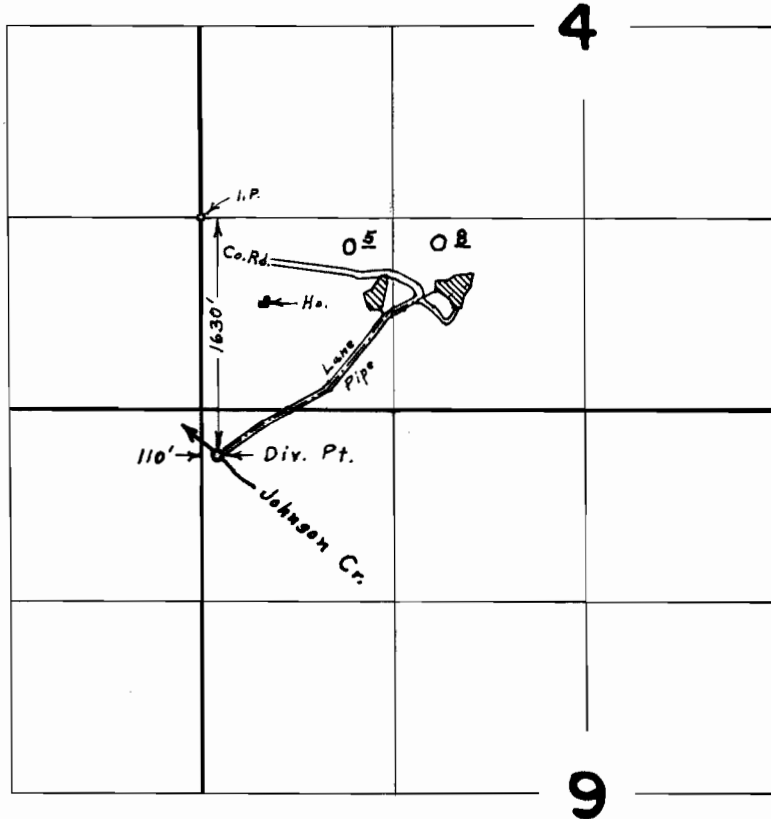

**FINAL PROOF SURVEY**  
UNDER

Application No. 31234 Permit No. 24615  
IN NAME OF  
**RONNY O. HAGA**

Surveyed July 18, 1968, by L. E. Gould