


T. 28 S. R. 14 W. W.M.

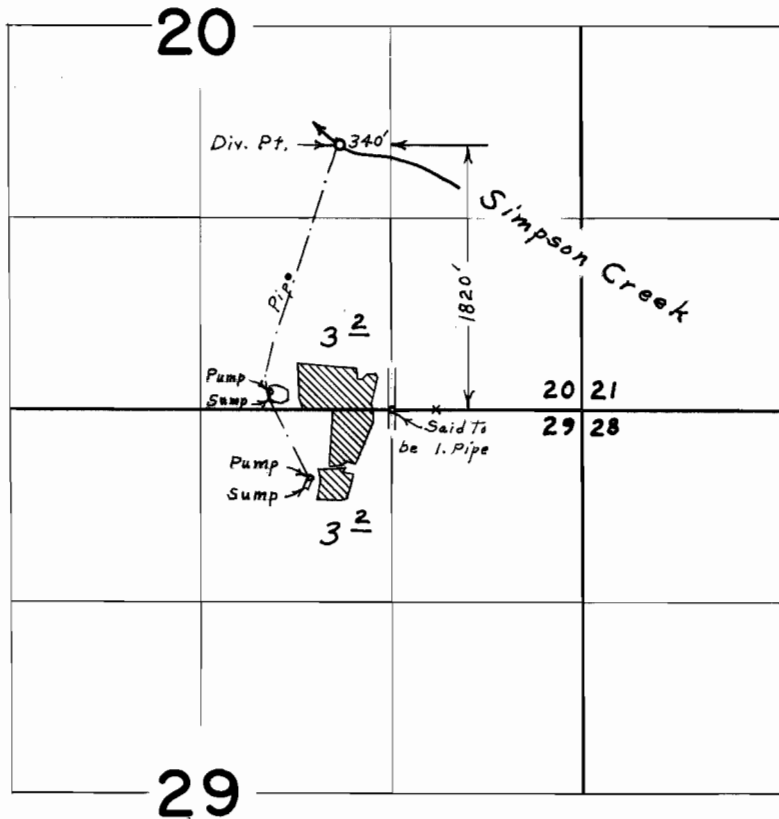

**FINAL PROOF SURVEY**  
UNDER

Application No. 32829 Permit No. 26056  
IN NAME OF

CURTIS F. SIMPSON

Surveyed July 13, 1968, by L. E. Gould