


T. 28 S. R. 12 & 13 W. W. M.

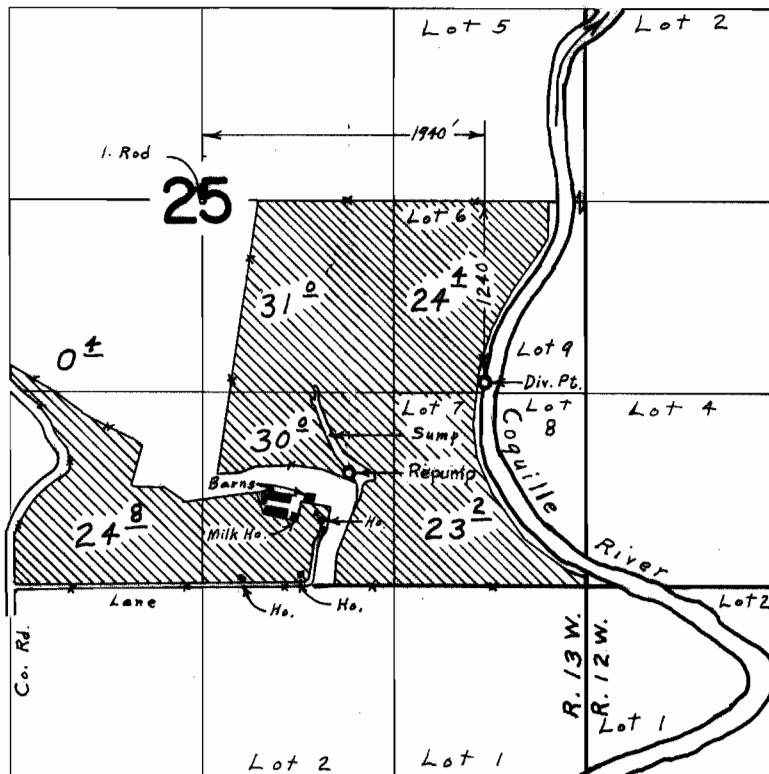

FINAL PROOF SURVEY UNDER

Application No. 39658 Permit No. 2947.8
IN NAME OF

GALE D. & JANET M. ROOD

Surveyed May 26, 1967, by L. E. Gould