


# T. 28 S. R. 14 W. W.M.

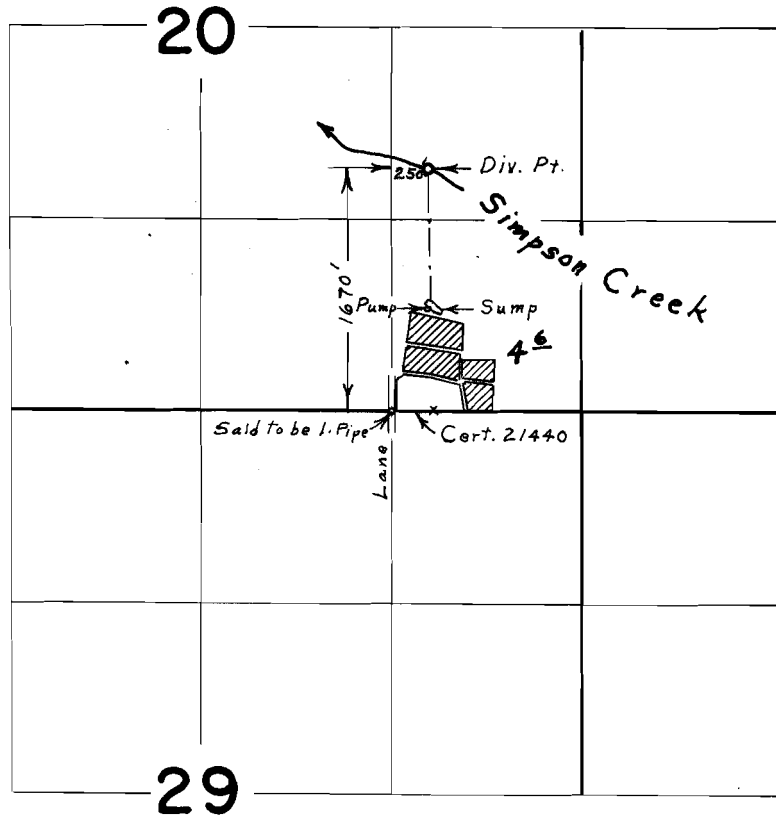

## FINAL PROOF SURVEY UNDER

Application No. 43599 Permit No. 32599  
IN NAME OF

RAYMOND H. SMITH

Surveyed July 12, 1968, by L. E. Gould