
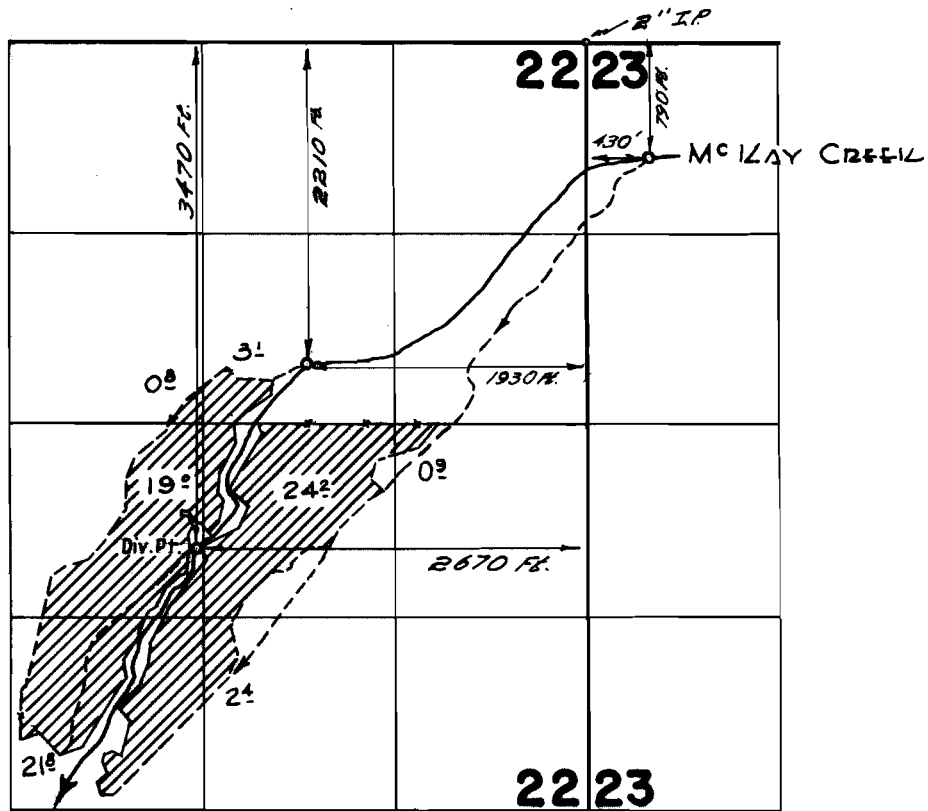
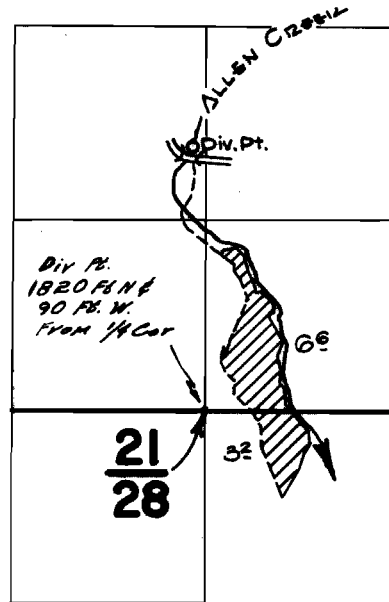


T.13S.R.16E.W.M.

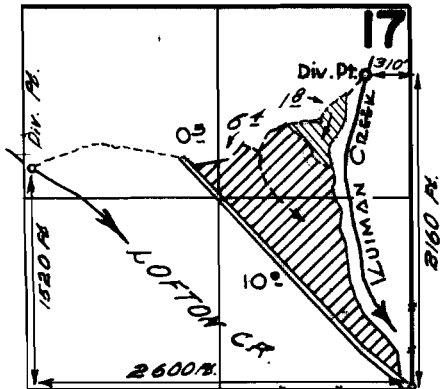

FINAL PROOF SURVEY
UNDER

Application No. 32417... Permit No. 25593...
IN NAME OF

FLOYD M. JONES

Surveyed July 18-19 1963, by T. LAUER.....
June 4, 1968 by W. d. Rupperts

Rd