


T.32 S.R.6 W.W.M.

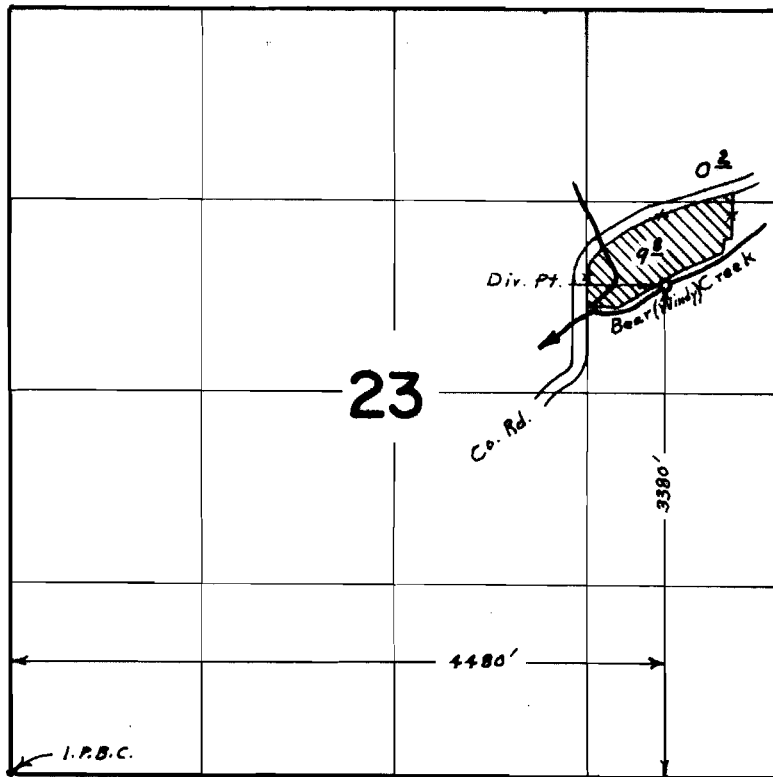

FINAL PROOF SURVEY UNDER

Application No. 32318 Permit No. 25504
IN NAME OF

JOHN M. & ROSE S. GLEAVE

Surveyed May 2, 1968, by L. E. Gould