


N-870 2122

T. 25 S. R. 7 W. W.M.

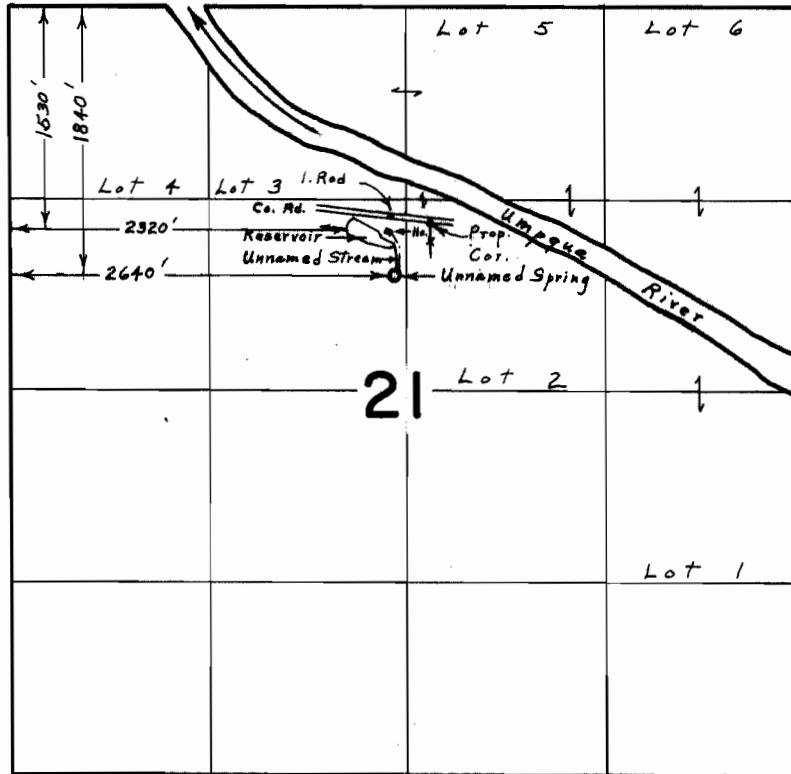

FINAL PROOF SURVEY UNDER

R-37523 R-2961
 Application No. 37524 Permit No. 28029
 IN NAME OF
E. E. NANCE

Surveyed June 7, 1967, by L. E. Gould