


T. 25 S. R. 7 W. W. M.

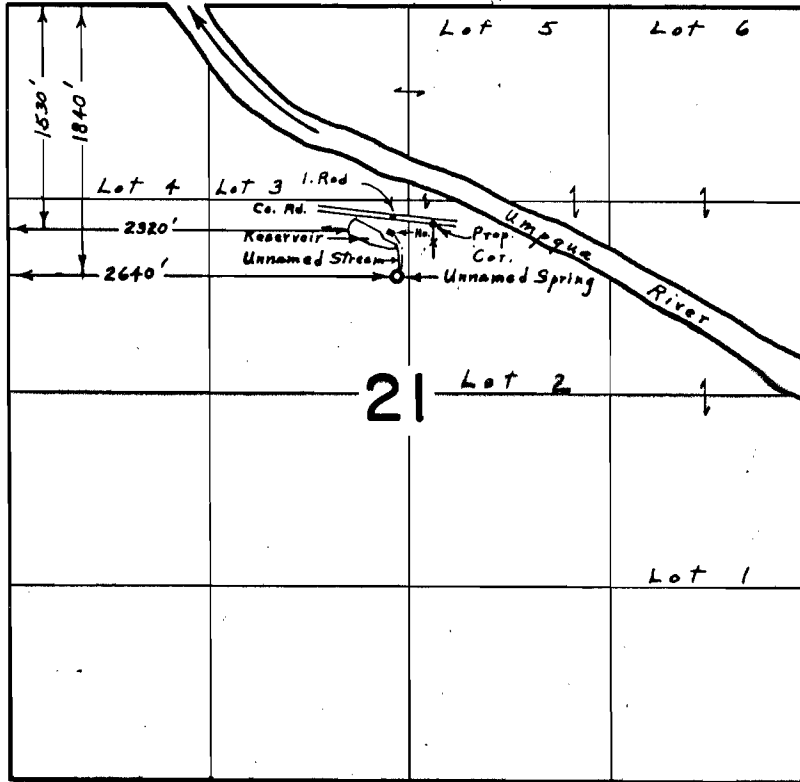

**FINAL PROOF SURVEY**  
UNDER

R-37523                      R-2961  
Application No. 37524    Permit No. 28029  
IN NAME OF  
**E. E. NANCE**

.....  
Surveyed June 7, 1967, by L. E. Gould.....