



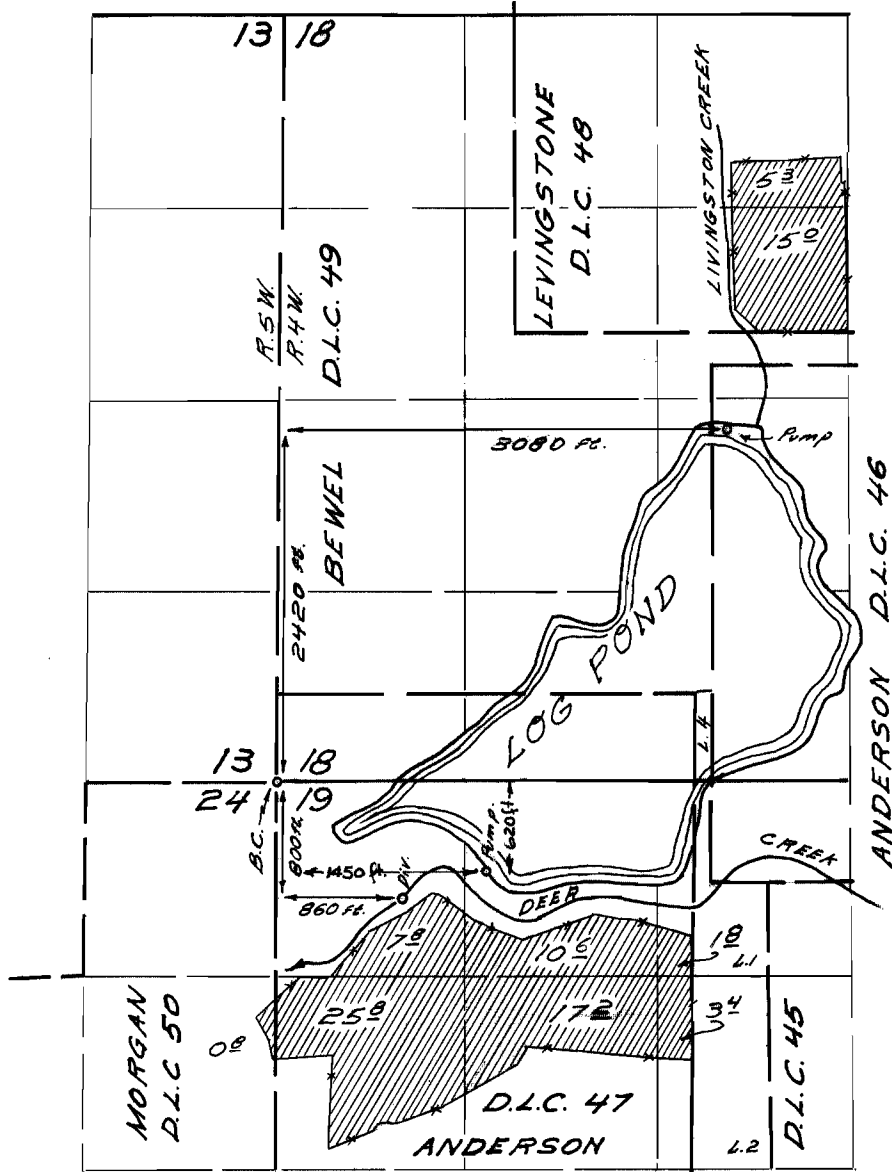

FINAL PROOF SURVEY UNDER

R-39238

R-3861

Application No. 39239 Permit No. 29158

IN NAME OF

Don E. & Betty J. Bailey
Meredith M. & Maxine Shattuck
 Surveyed *April 25, 1967*, by *W. J. Ruppert*
May 8, 1967