T. 32 S. R. 6 W. W. M.

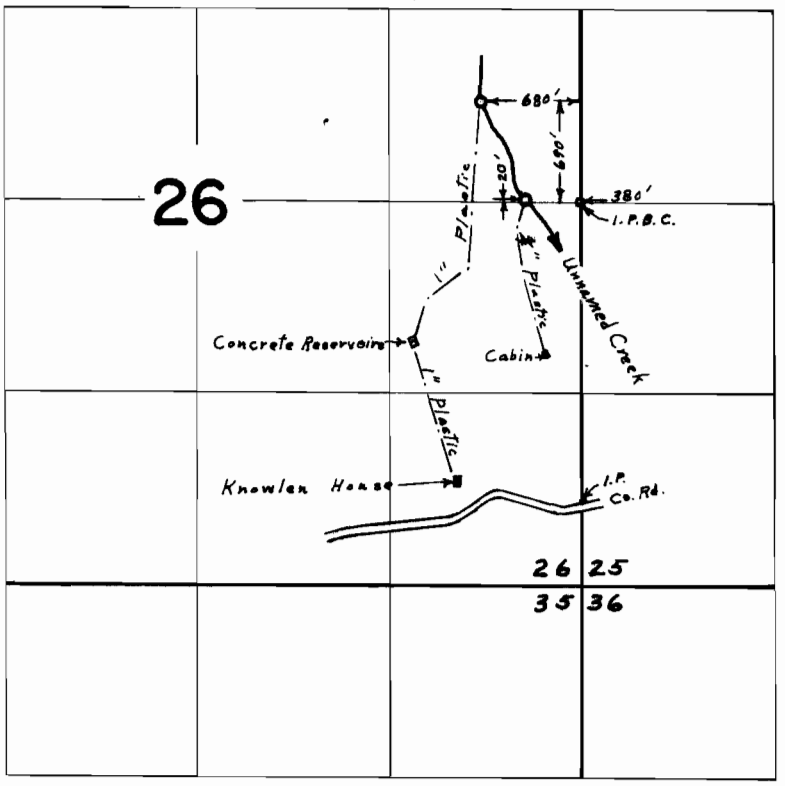

FINAL PROOF SURVEY
UNDER

Application No. 40279 Permit No. 30026
IN NAME OF
HARRY W. & LAURA B. KNOWLEN

Surveyed April 30, 1968, by L. E. Gould

1968-S