


T.24S.R.7W.W.M.

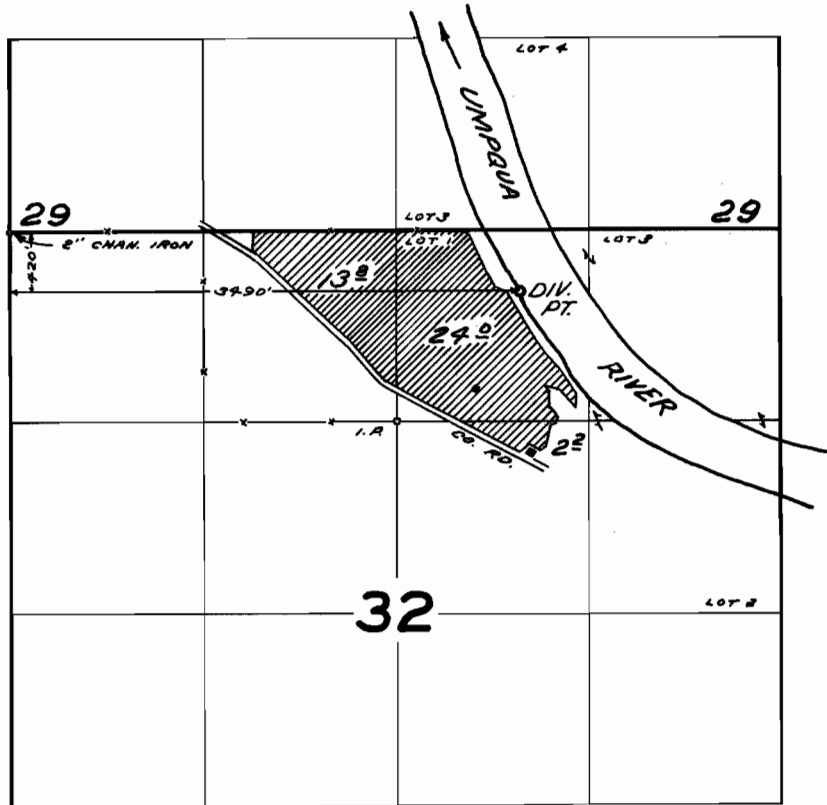

FINAL PROOF SURVEY
UNDER

Application No. 40932 Permit No. 30501
IN NAME OF

FORREST L. CAGLE AND RAY E. CAGLE

Surveyed APR. 18 1967, by V. GARNER
MAY 2 1968