


T.13S. R.31E.W.M.

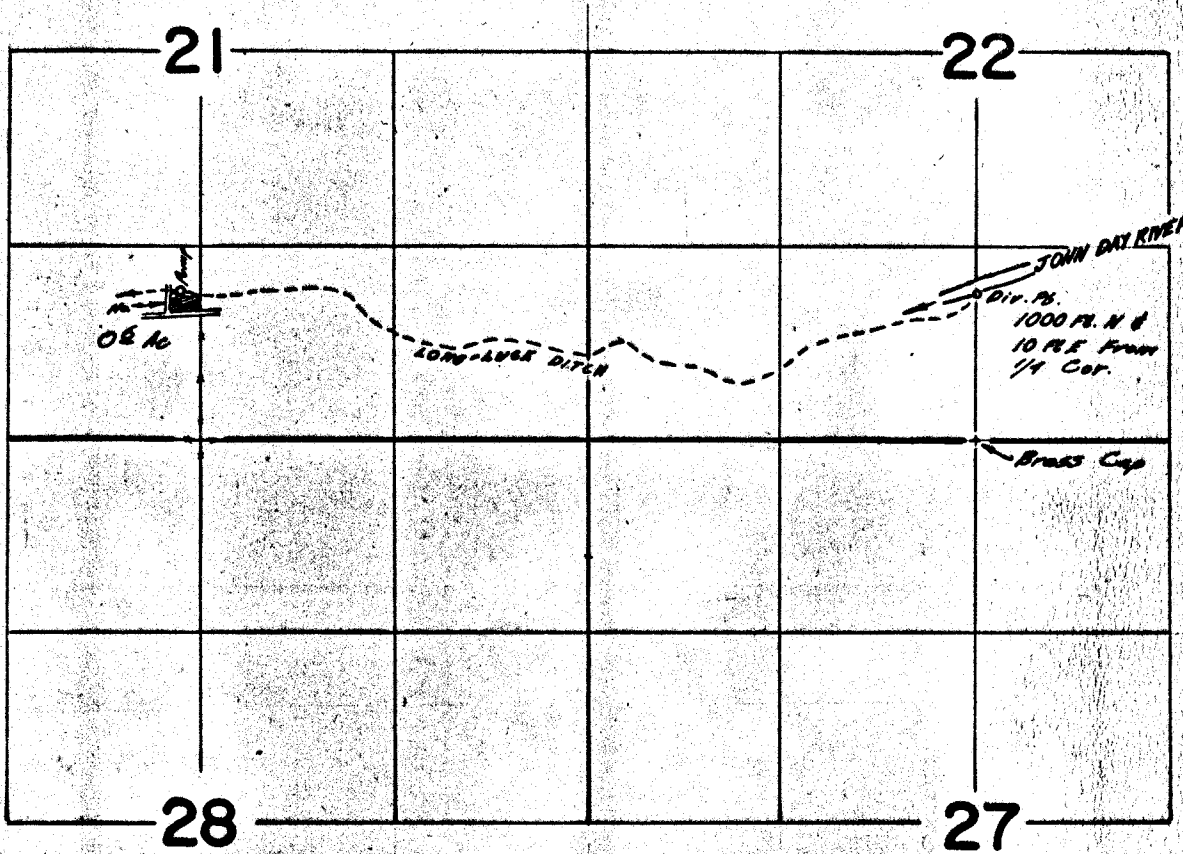

FINAL PROOF SURVEY UNDER

Application No. 37369 Permit No. 27817
IN NAME OF

JERRY D. & FLORA E. CHEADLE

Surveyed July 9, 1968, by *W.D. Ruppert*