


P-31430
35736

T. 13 S. R. 28 E. W. M.

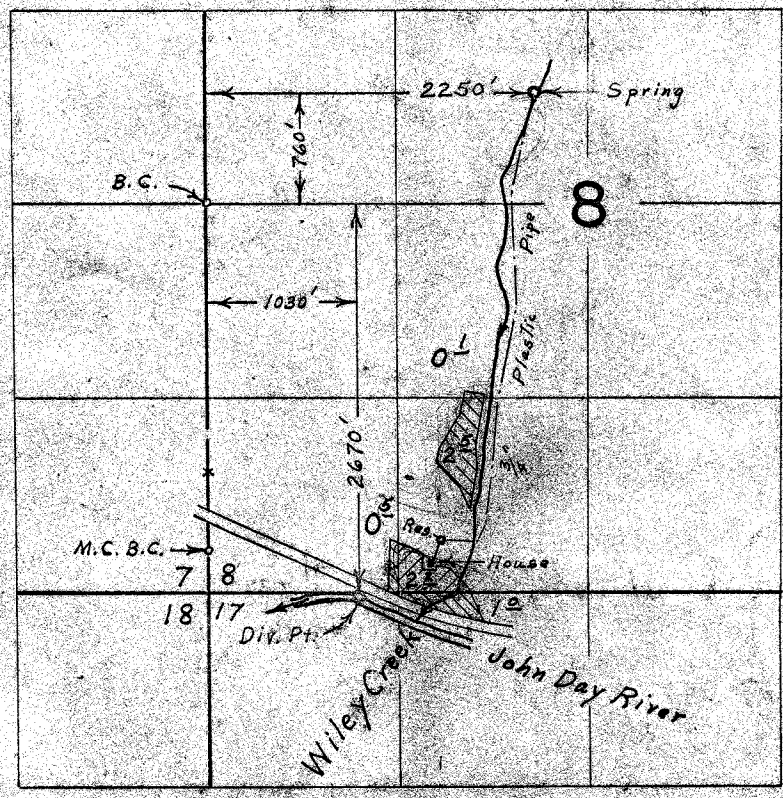

Primary 
Supplemental 

FINAL PROOF SURVEY UNDER

Application No. ~~41998~~ ⁴²⁰⁹⁵ Permit No. ~~31430~~ ³¹⁵⁹¹
IN NAME OF

SAM & MARY THOMPSON

Surveyed June 4, 1968, by L. E. Gould.