


P-31501  
35737

# T. 13 S. R. 28 E. W. M.

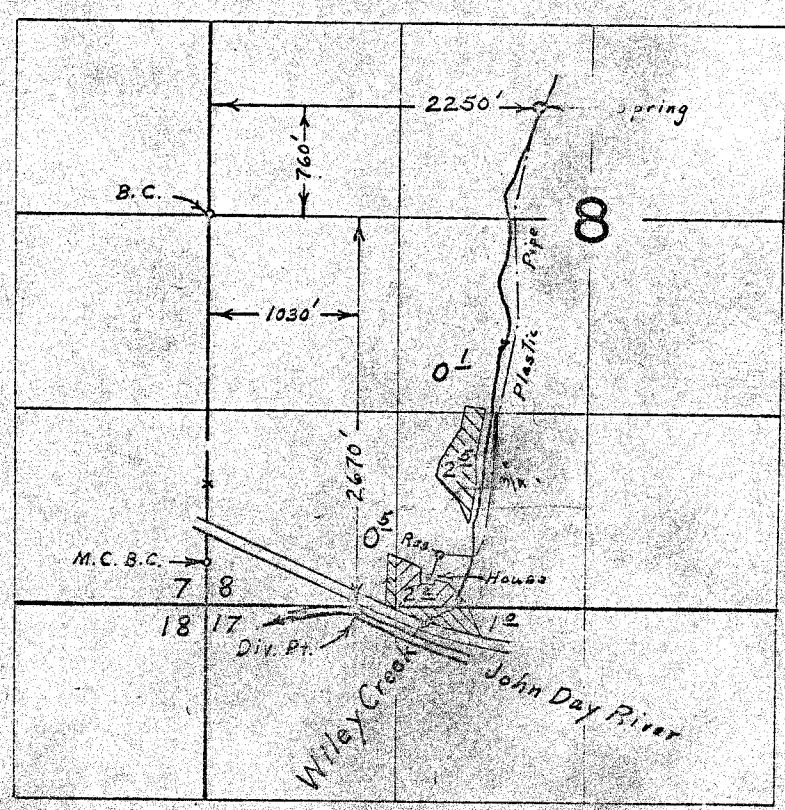

Primary   
 Supplemental 

## FINAL PROOF SURVEY UNDER

Application No. <sup>41998</sup> 42095. Permit No. <sup>31230</sup> 31501  
 IN NAME OF

SAM & MARY THOMPSON

Surveyed June 4, 1968, by L. E. Gould