


T.36 S.R.1&2 E.W.M.

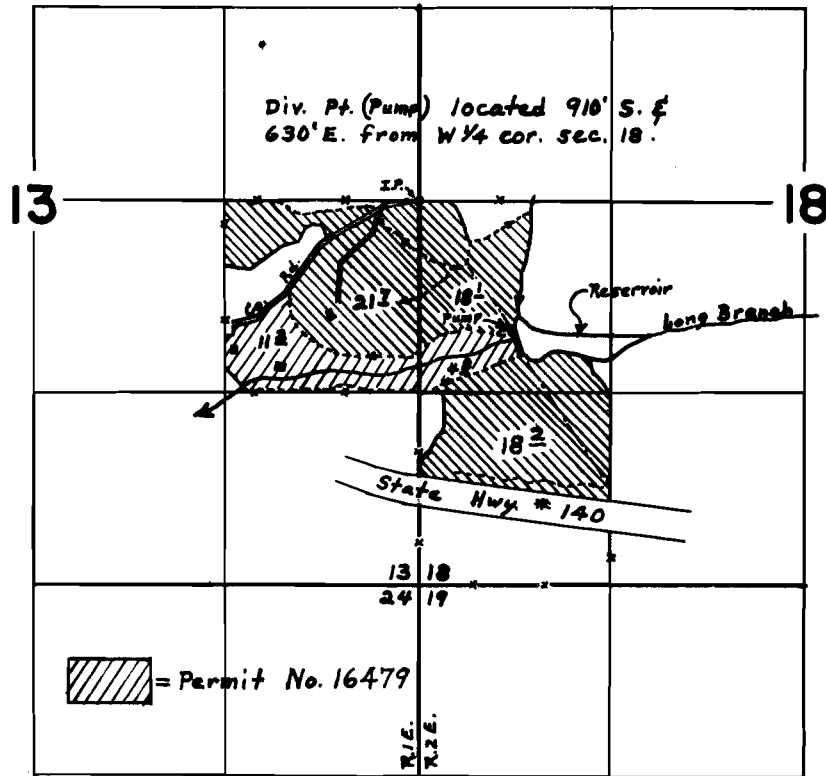

FINAL PROOF SURVEY
UNDER

30444 23906
Application No. R-30443 Permit No. R-1803
IN NAME OF

THEODORE BLOOMBERG, et al.

Surveyed May 25, 1967, by W. J. Ruppert
June 21, 1967 by D. L. Hendrix