
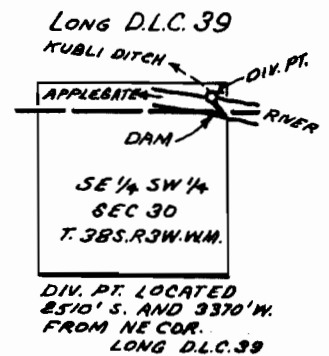


# T.38S.R.4W.W.M.

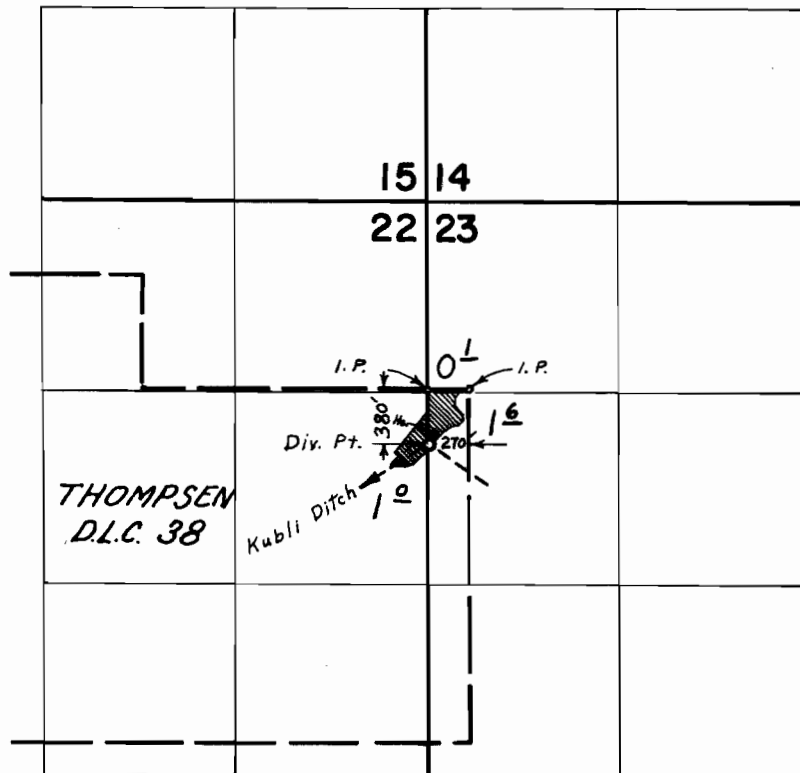

## FINAL PROOF SURVEY UNDER

Application No. 34792 Permit No. 27328  
 IN NAME OF  
**M. C. ROWDEN**

Surveyed July 29 1967, by L. E. Gould

For Div. Pt. see F.P. map, H-160