


T.38 S.R.3 W.W.M.

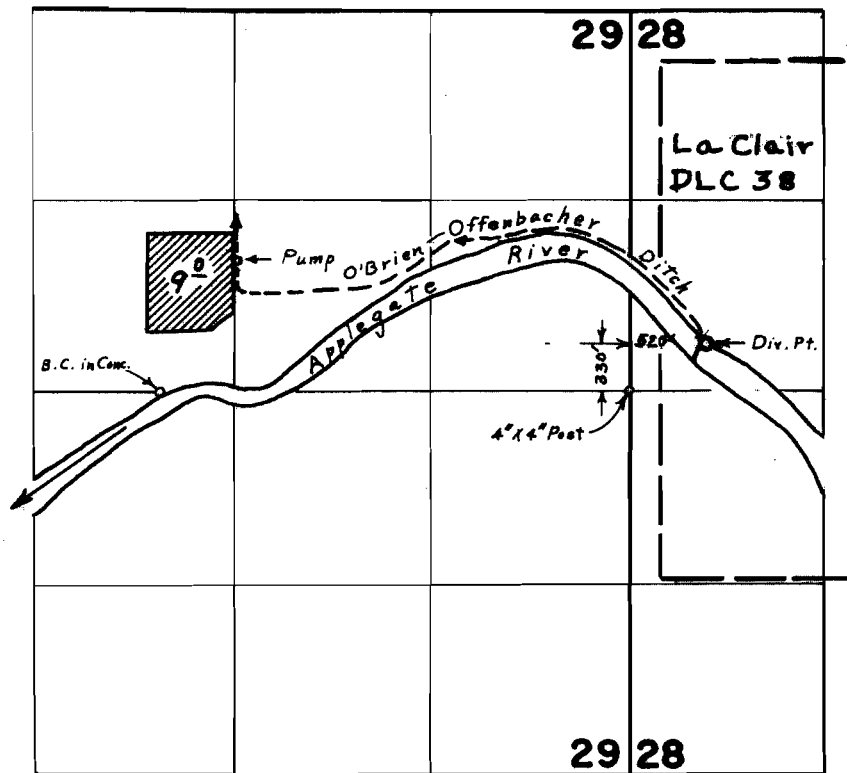

FINAL PROOF SURVEY UNDER

Application No. 41842. Permit No. 31312...
IN NAME OF
HARLAN P. BOSWORTH, JR.
B. MARIE M. BOSWORTH

Surveyed July 29, 1967, by L. E. Gould...