


T. 11 S. R. 13 & 14 E. W. M.

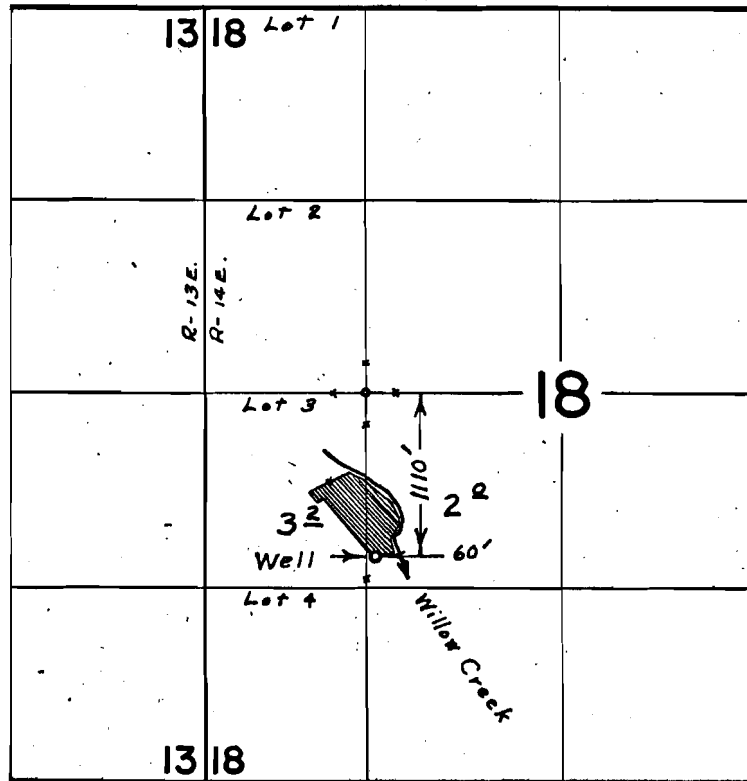

FINAL PROOF SURVEY UNDER

Application No. G-2552 Permit No. G-2389
IN NAME OF

ALBERT C. SURATT

Surveyed Oct. 25, 1967., by L. E. Gould.....

G-2389
1967-W