


5
C35744
68375

T.13S.R.9E.W.M.

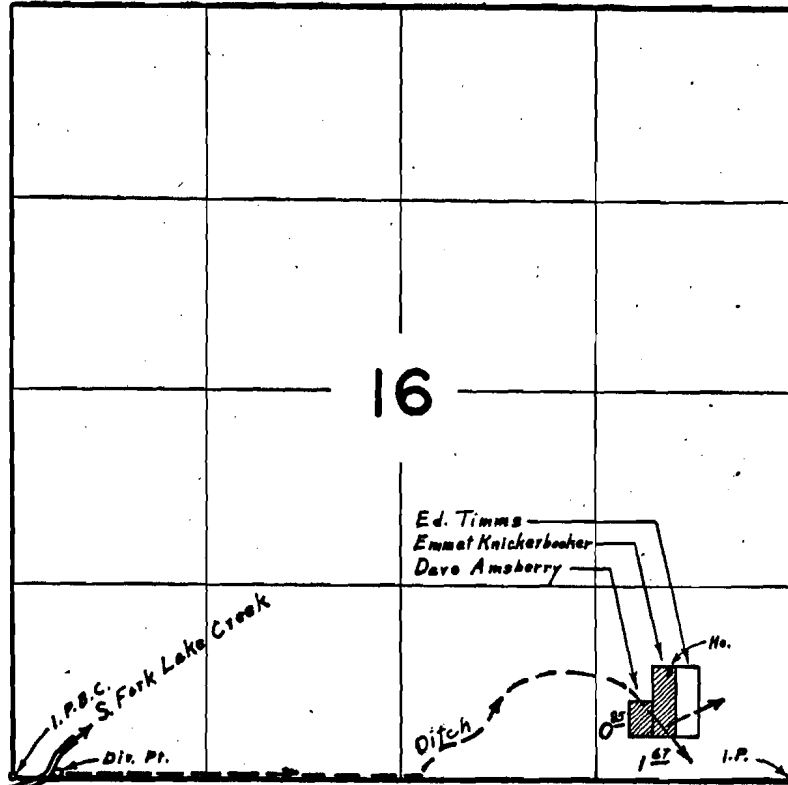

Div. Pt. located 30' N. & 300' E. from The S.W. Cor. Sec. 16

FINAL PROOF SURVEY UNDER

Application No. 38908... Permit No. 28961...

IN NAME OF

DAVE AMSBERRY

Surveyed July 11, 1967., by L. E. Gould...

P# 28961
1967-U