


T.39S. R.5W.W.M.

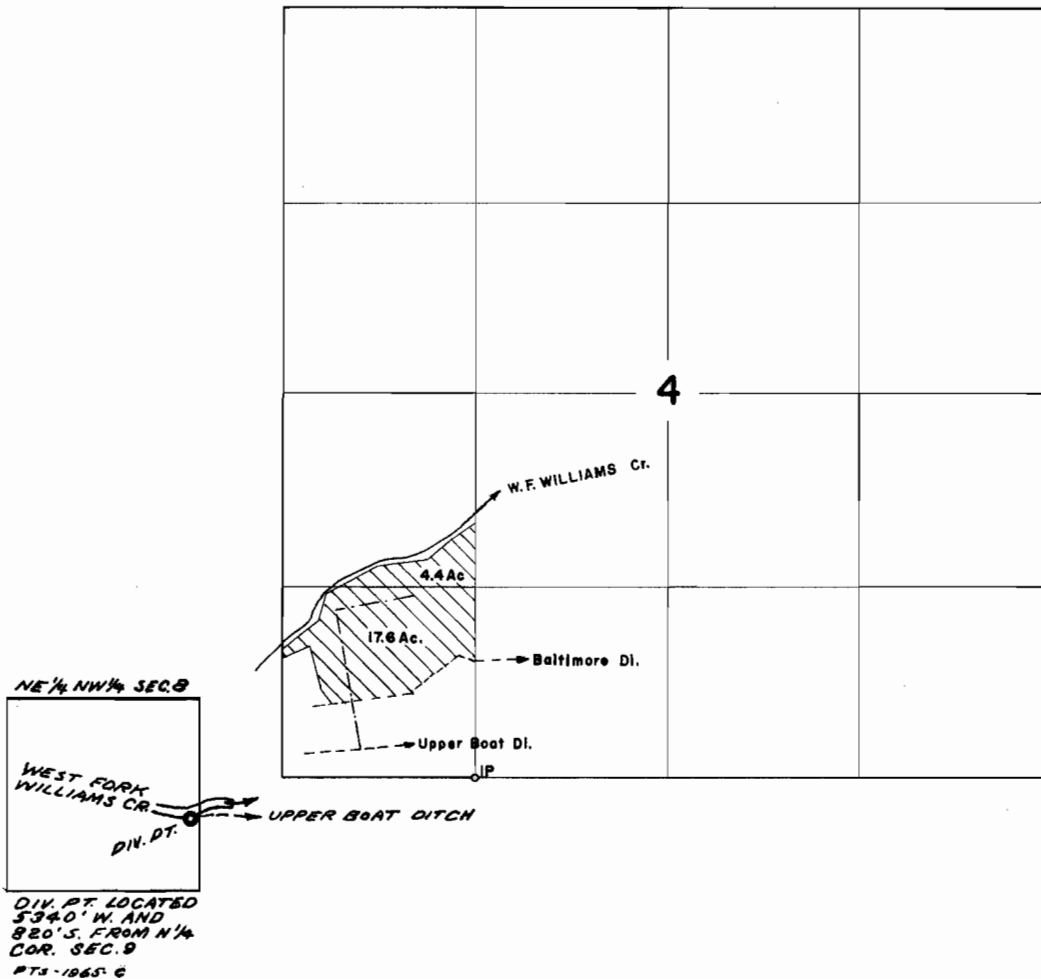

FINAL PROOF SURVEY UNDER

Application No. 39868 Permit No. 29675
IN NAME OF

JAMES L. LATHROP

Surveyed OCT. 9 1968, by R.B. Steimer