


T.36 S.R.5 W.W.M.

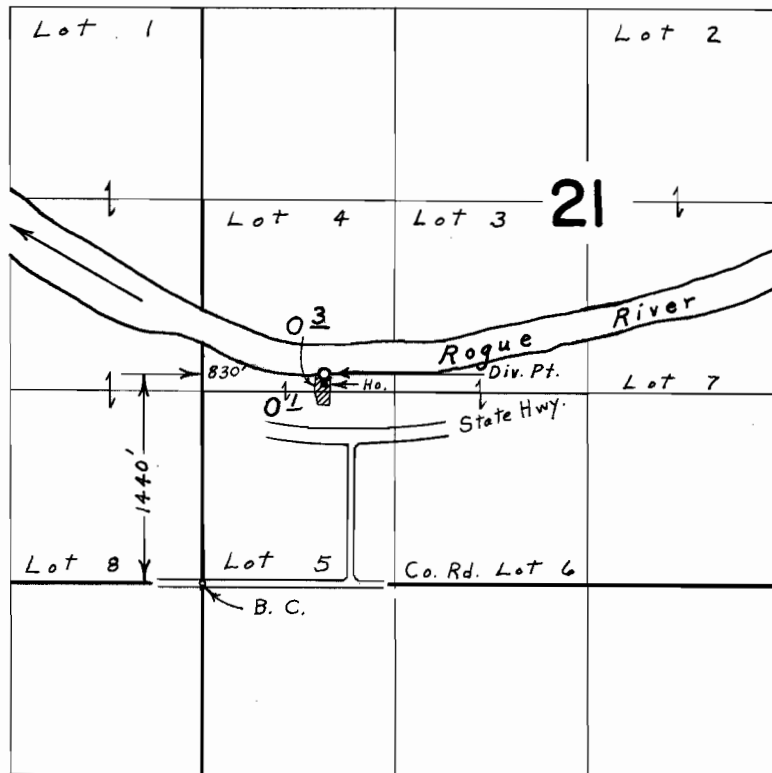

FINAL PROOF SURVEY UNDER

Application No. 42888 Permit No. 32052
IN NAME OF
BERT E. & OR PHYLLIS E. MICHAELS

Surveyed Aug. 24, 1967, by L. E. Gould