


G. 1092

13

35750

# T.27 S. R. 15 E. W.M.

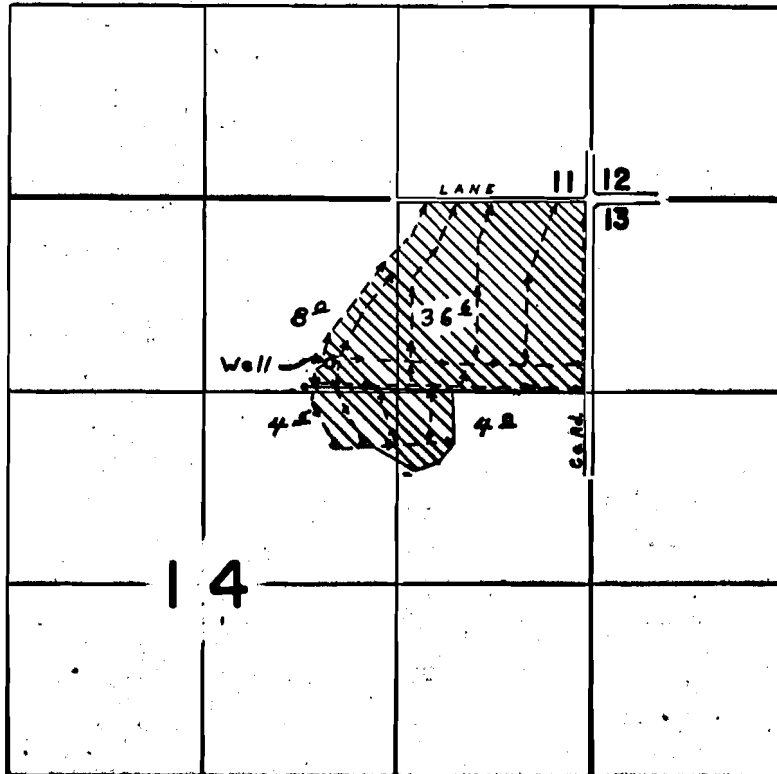

## FINAL PROOF SURVEY UNDER

Application No. G-1022. Permit No. G-1092.  
IN NAME OF

THELMA C. HEILMEYER OWSLEY

Surveyed JULY 31 1968, by L. E. GOULD.