T.18S.R.2&3W.W.M.

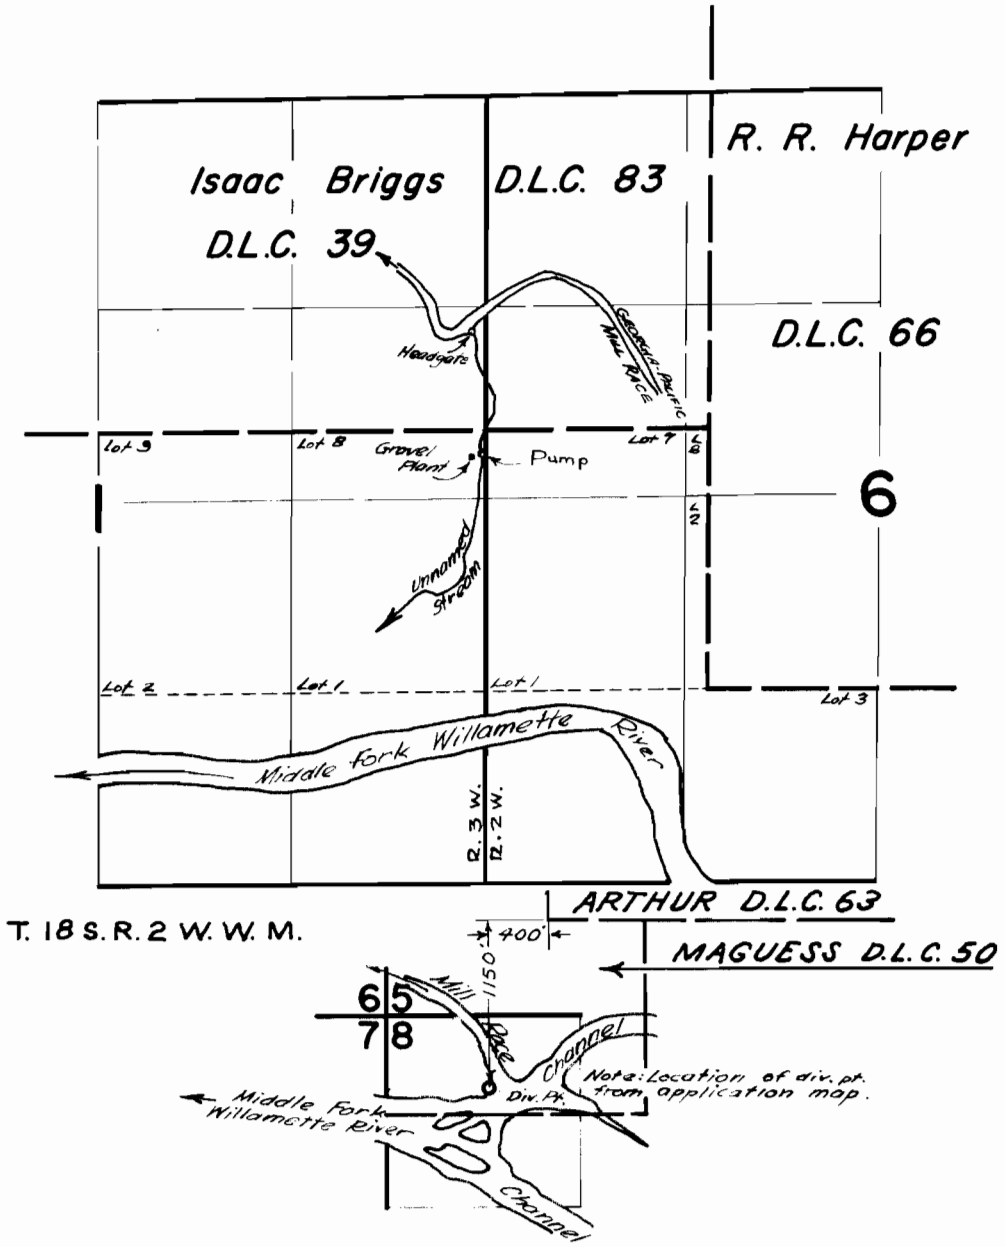

FINAL PROOF SURVEY
UNDER

Application No. 39171 Permit No. 29218
IN NAME OF

SPRINGFIELD SAND & GRAVEL CO.

Surveyed May 5 1965, by R H Jackson

1965-A