


T.15 S.R.4 W.W.M.

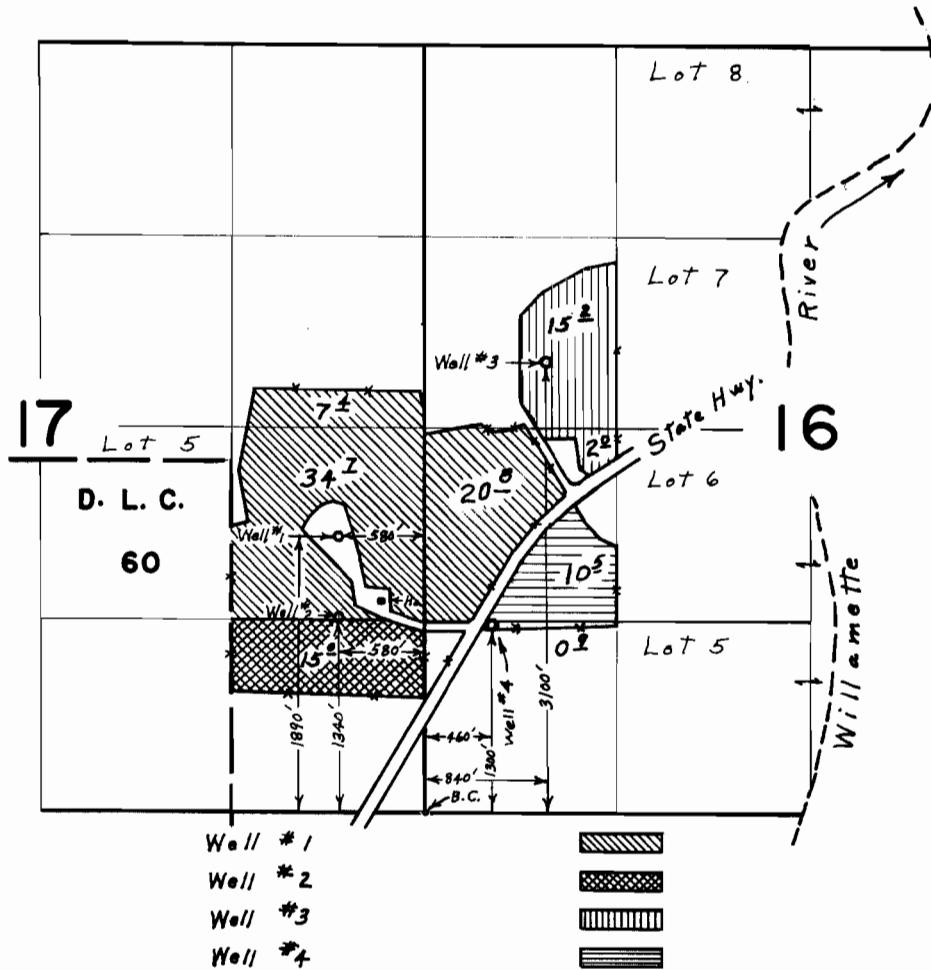

FINAL PROOF SURVEY UNDER

Application No. G-3350 Permit No. G-3144
 IN NAME OF
VIRGINIA SCOTT

Surveyed May 1, 1967, by L. E. Gould