


T.19 S.R.6 W.W.M.

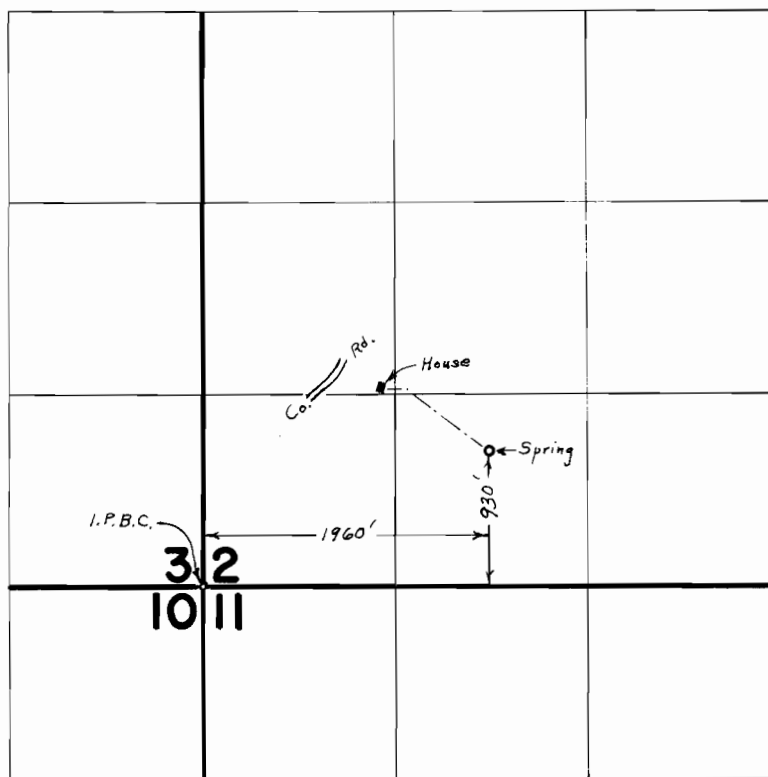

FINAL PROOF SURVEY
UNDER

Application No. **35090** Permit No. **27455**
IN NAME OF

DELMER M. MARSH

Surveyed April 29, 1965, by *R. E. Peterson*
July 20, 1967, by L. E. Gould