


T.16 S.R.7 W.W.M.

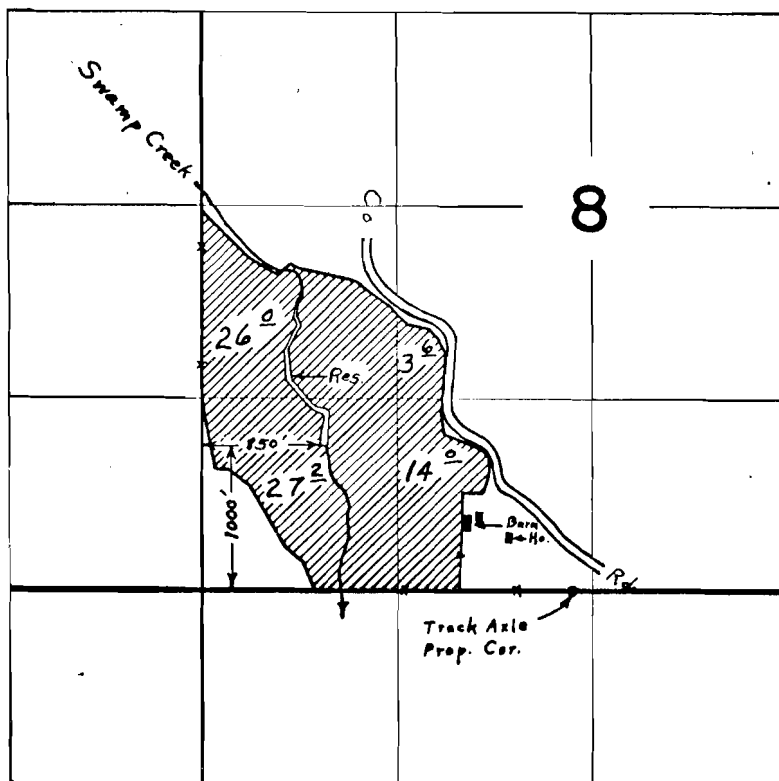

FINAL PROOF SURVEY
UNDER

R-37773 R-3151
Application No. 38029... Permit No. 28377...
IN NAME OF
JOHN T. GRIFFITH

Surveyed May 11, 1967, by L. E. Gould