


T.18S.R.5W.W.M.

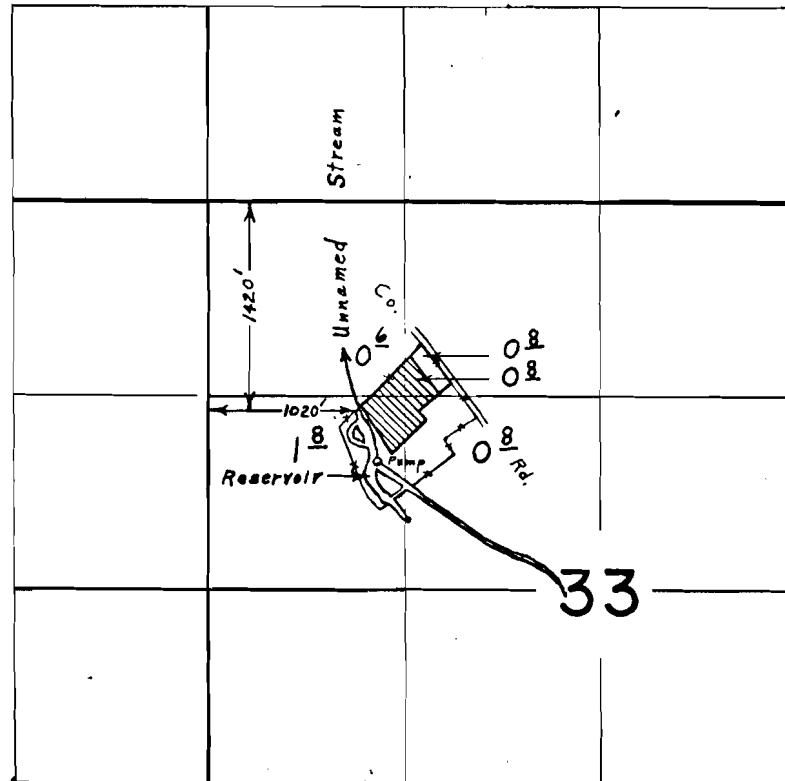

FINAL PROOF SURVEY
UNDER

Application No: R-38255 38378 Permit No. R-3208 28601
IN NAME OF

HENRY C. TAYLOR

Surveyed July 20, 1967, by L. E. Gould