


T.17S.R.5W.W.M.

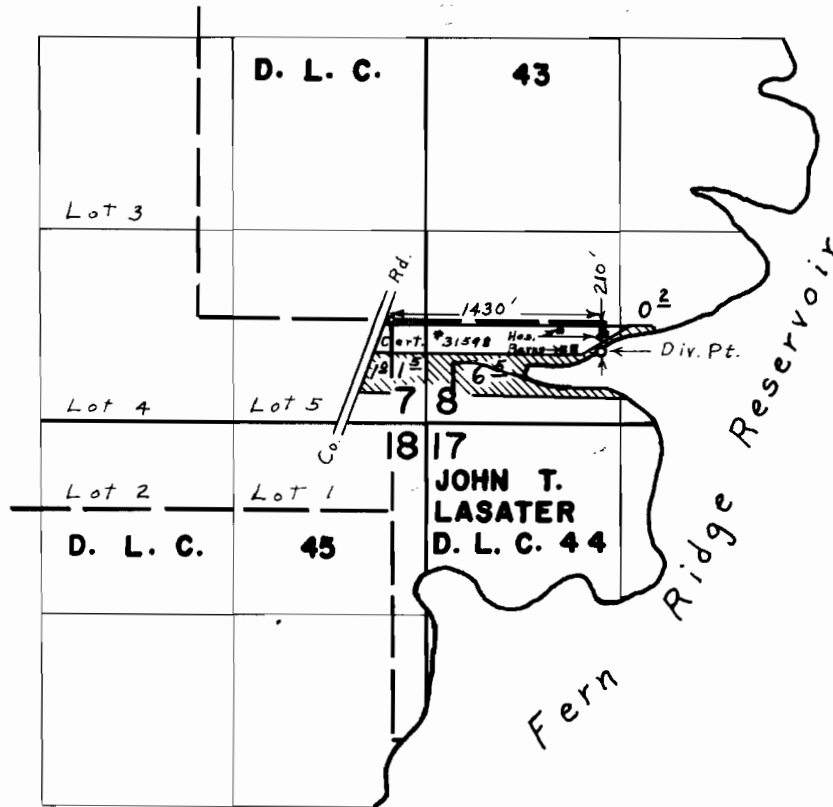

FINAL PROOF SURVEY
UNDER

Application No. 37576 Permit No. 28797
IN NAME OF

CARROL D. PARKINSON, M. D.

Surveyed July 17, 1967, by L. E. Gould